MISSISSIPPI DEPARTMENT OF ENVIRONMENTAL QUALITY
Office of Land and Water Resources

P. O. Box 10631
Jackson, MS 39289-0631

WATER WELL DRILLERS LOG

COUNTY WELL LOCATED: Wayne
WELL NUMBER: G-20749 | CODED:
DATE WELL COMPLETED:

PERMIT NUMBER:
NAME OF DRILLING FIRM: Roy V. West

NAME & MAILING ADDRESS OF LANDOWNER: J. T. Purvis

WELL LOCATION: SEC 5 TOWNSHIP 9 N/S RANGE 8 E/W

DISTANCE: 9 Miles DIRECTION: NW NEAREST TOWN: of Waynesboro

OTHER LANDMARK: Evergreen Church

WELL PURPOSE: Home, Irrigation, Municipal, Industrial, Fish Pond, etc.: Livestock

PUMP DATA

PUMP TYPE (Circle One): (Submersible) Turbine, Jet, Flowing Well, Other (Describe)

POWER TYPE (Circle One): (Electric) Tractor, Diesel, Gasoline, Butane, Other (Describe) H/P 1

Pump Capacity (GPM)	No. of Stages	Setting Depth
5		175' FT.

PUMP TEST

Well yielded _____ GPM with a drawdown of _____ ft. after _____ hours of pumping

WELL DATA

Well Depth	Casing Diameter (In.)	Casing Length (Ft.)
220	4	177'

Type of Casing	Hole Depth	Depth to Static Water Level
PVC	220	120

TYPE OF COMPLETION: (Circle One or More): Gravel Packed, Underreamed, Telescoped, Natural Development, (Open Hole), Other (Describe)

WELL GROUTED TO A DEPTH OF 10 FEET
Type Grout (circle one): (Cement) Bentonite, or Mix

LOG DATA

TYPE OF LOG RUN (Circle One): (No Log Run) Electric, Gamma Ray, Density, Sonic, Neutron, Other (Describe)

Name of Organization Running Log

GEOLOGIC DATA (Office Use Only)

Surface Elev.	Geologic Unit	Unit Thickness	Depth to Top
Subs. SWL	Date	Analysis	Aquifer Test

Driller's Remarks

Top of Lap Pipe or Reduction in Casing FEET

IF TELESCOPED OR MORE THAN ONE SCREEN: USE BACK PAGE

SCREEN DATA

Diameter - Inches	Length - Feet	Slot Size - Inches
no screen		

Screen Type	Depth to Bottom - Feet

DESCRIPTION OF FORMATIONS ENCOUNTERED	FROM	TO
SANDY CLAY	0	12
CLAY	12	16
SAND	16	47
CLAY W/SAND STRKS	47	78
Blue clay	78	122
SANDSTONE	122	123½
Clay	123½	171
limestone	171	172
CLAY	172	175
Limestone solid	175	176
Fractured limestone	176	220

FORMATIONS (Continued)	FROM	TO

RECEIVED
FEB 02 2001
Dept. of Environmental Quality
Office of Land & Water Resources

IF MORE SPACE IS NEEDED, USE BACK

If well telescopes please sketch and show depths.

GROUND LEVEL

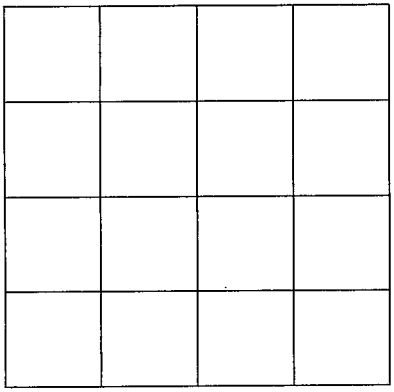

SECTION _____

Please indicate well location X.

ADDITIONAL INFORMATION

If more than one screen, show location of each on sketch.