WAYNE
H 208
4-20-76

13P

MISSISSIPPI
BOARD OF WATER COMMISSIONERS
416 North State Street
Jackson, Mississippi 39201

WATER WELL DRILLERS LOG

Apr 20 1976 19 — McILWAIN WATER WELL SERVICE — WAYNE
date well completed — firm name — county well located

RT. 2, BOX 37
WAYNESBORO, MISS. 39367

LANDOWNER: Mr. Melvin Evans
Waynesboro, Miss.
(mailing address)

WELL LOCATION:
sec. 27 T 9 N R 7 W
4 (distance) miles NW (direction) of W'BORO (nearest town)

WELL PURPOSE: Home
(home, irrigation, municipal, industrial)

WELL COMPLETION DATA:

(1) diameter (inches) 4" X 2"
(2) total depth (feet) 76'
(3) static water level (feet) 20' below ~~above~~ top of ground.
(4) casing PVC (material) 4" - 18' 2" - 68' (depth)
_____ (size) if telescope see back.
(5) screen 8' (length), 68' (depth to top)
2" (size), PVC (material)
(6) pump 3/4 (HP) 12 (yield gpm)
220 AC (type power)
(7) electric log no (yes or no)
_____ (organization running log)
(8) how well bottom plugged

DRILLERS REMARKS:

description of formations encountered	from	to
Sand	0	5
Rock, shells, + Clay	5	35
Clay	35	65
Med Sand	65	76

APR 26 1976
BD. OF WATER COMM.

If well telescopes please sketch and show depths.

GROUND LEVEL

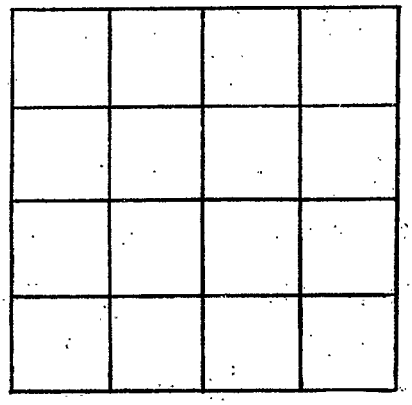

SECTION _____

Please indicate well location X.

ADDITIONAL INFORMATION

If more than one screen, show locations of each on sketch.