MISSISSIPPI DEPARTMENT OF NATURAL RESOURCES

Bureau of Land and Water Resources

P.O. Box 10631
Jackson, Mississippi 39209
WATER WELL DRILLERS LOG

COUNTY WELL LOCATED: Wayne Co	
WELL NUMBER: H	CODED:
PERMIT NUMBER: 2863	
DATE WELL COMPLETED: 8-22-89	NAME OF DRILLING FIRM: McDonald & Hice, Meridian, Ms.

NAME & MAILING ADDRESS OF LANDOWNER: George Waller, Rt 1 Box 752, Waynesboro, Ms.

WELL LOCATION: SEC 20 TOWNSHIP 9 (N) S RANGE 7 (E) W

DISTANCE: 5 Miles DIRECTION: NW of NEAREST TOWN: Waynesboro

OTHER LANDMARK:

WELL PURPOSE: (Home), Irrigation, Municipal, Industrial, Fish Pond, etc.

PUMP DATA

PUMP TYPE (Circle One): Submersible, Turbine, (Jet) Flowing Well, Other (Describe)

POWER TYPE (Circle One): (Electric), Tractor, Diesel, Gasoline, Butane, Other (Describe)

Pump Capacity (GPM)	No. of Stages	Setting Depth
5	3	92 FT.

PUMP TEST

Well yielded _____ GPM with a drawdown of _____ ft. after _____ hours of pumping

WELL DATA

Well Depth	Casing Diameter (In.)	Casing Length (Ft.)
102	2	92 + 10
Type of Casing	**Hole Depth**	**Depth to Static Water Level**
PVC	102	92

TYPE OF COMPLETION: (Circle One or More): (Gravel Packed), Underreamed, Telescoped, Natural Development, Open Hole, Other (Describe)

Top of Lap Pipe or Reduction in Casing: FEET

IF TELESCOPED OR MORE THAN ONE SCREEN: USE BACK PAGE

SCREEN DATA

Diameter - Inches	Length - Feet	Slot Size - Inches
2	10	12
Screen Type	**Depth to Bottom - Feet**	
PVC	102	

LOG DATA

TYPE OF LOG RUN (Circle One): No Log Run, Electric, Gamma Ray, Density, Sonic, Neutron, Other (Describe)

Name of Organization Running Log

GEOLOGIC DATA (Office Use Only)

Surface Elev.	Geologic Unit	Unit Thickness	Depth to Top
Subs. SWL	Date	Analysis	Aquifer Test

Driller's Remarks: 18 ft tail pipe

DESCRIPTION OF FORMATIONS ENCOUNTERED	FROM	TO	FORMATIONS (Continued)	FROM	TO
Clay, Sand	0	15			
~~Sand~~ Med Sand	15	87			
Course Sand	87	105			
Clay, Shale	105	112			
			IF MORE SPACE IS NEEDED, USE BACK		

RECEIVED
SEP 5 1989
Department of Natural Resources
Bureau of Land & Water Resources

If well telescopes please
sketch and show depths.

GROUND LEVEL

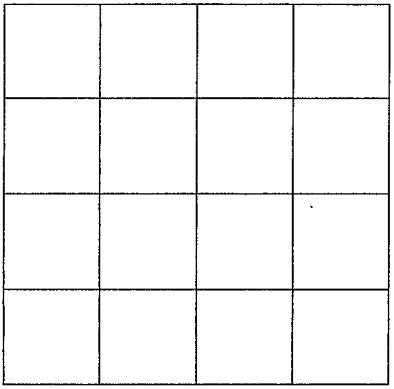

SECTION _____

Please indicate well location X.

ADDITIONAL INFORMATION

If more than one screen,
show location of each on sketch.