

J<sup>15</sup>

12-18-62

WATER WELL DRILLERS LOG

Date: Dec 18, 1962, Driller: Porter Drilling & Exp. Co. Wayne  
 (Name)

(1) Owner of Land: W. W. Middleton  
 (Name)

at 4 Haynesboro  
 (Address)

(2) Location: NE 1/4, NW 1/4, Sec. 30 T 9 R 6

4 miles north of Waynesboro  
 (distance) (direction) (Nearest Town)

(3) Topography: hilly  
 (Hilly) (Flat) (Level)

(4) Purpose of Well: domestic  
 (Domestic Irrigation Municipal, Industrial, Other)

Description & Color of Materials Sand, Clay, Red Clay, Shell, etc.	Thick- ness Feet	Depth Feet
<u>red clay</u>	<u>6</u>	<u>6</u>
<u>blue chalk</u>	<u>6</u>	<u>12</u>
<u>red chalk</u>	<u>16</u>	<u>28</u>
<u>blue chalk</u>	<u>7</u>	<u>35</u>
<u>red chalk</u>	<u>20</u>	<u>55</u>
<u>loose rotten formation</u>	<u>6</u>	<u>61</u>
<u>strata of rock</u>	<u>9</u>	<u>70</u>
<u>blue chalk</u>	<u>15</u>	<u>85</u>
<u>grey sand</u>	<u>8</u>	<u>93</u>
<u>blue chalk</u>	<u>10</u>	<u>103</u>
<u>grey coarse sand with solid streaks of blue chalk &amp; streaks of lignite in last 6'</u>	<u>14</u>	<u>117</u>

Information upon completion of well:

(1) Diameter 2" inches.

(2) Total Depth 117' feet.

(3) Water Level 95' feet below top of ground.

(4) Cased to 105', Size 2"

(5) Screen: Size 1 1/4", Length 6'


(6) Were any formations sealed against pollution?

no  yes  no.

If YES depth of formation \_\_\_\_\_

Why \_\_\_\_\_

Drillers Remarks: \_\_\_\_\_

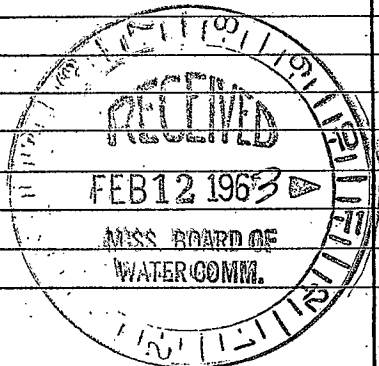

Well No.





