

WAYNE MISSISSIPPI BOARD OF WATER COMMISSIONERS

J 19

5-31-65

WATER WELL DRILLERS LOG


Date: May 31, 1965, Driller: Porter Drilling Co County Wayne
Moseley house (Name)

	Description & Color of Materials Sand, Clay, Red Clay, Shell, etc.	Thick- ness Feet	Depth Feet
(1) Owner of Land: <u>Nolan Clark</u> (Name)	<u>red clay</u>	<u>12</u>	<u>12</u>
<u>Waynesboro, Miss</u> (Address)	<u>sand</u>	<u>56</u>	<u>68</u>
(2) Location: <u>NE 1/4, NE 1/4, Sec 29 T9 R6</u>	<u>chals</u>	<u>1</u>	<u>69</u>
<u>4</u> miles <u>NE</u> , of <u>Waynesboro</u> (distance) (direction) (Nearest Town)			
(3) Topography: <u>Hilly</u> (Hilly) (Flat) (Level)			
(4) Purpose of Well: <u>domestic</u> (Domestic Irrigation Municipal, Industrial, Other)			

Information upon completion of well:

- (1) Diameter 2" inches.
- (2) Total Depth 68' feet.
- (3) Water Level 50' feet below top of ground.
- (4) Cased to 62', Size 2"
- (5) Screen: Size 1 1/4", Length 6'
60 ga
- (6) Were any formations sealed against pollution?
 yes, no.

If YES depth of formation _____
 Why _____
 Drillers Remarks: _____

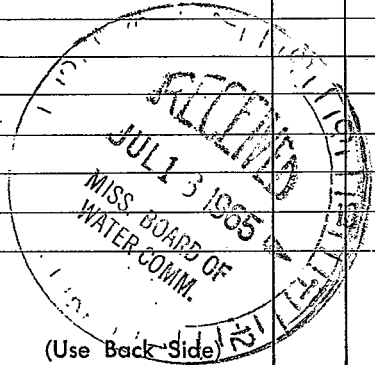

Well No. _____






