Wayne
9 42
11-16-69

MISSISSIPPI
BOARD OF WATER COMMISSIONERS
416 North State Street
Jackson, Mississippi 39201

CODED

WATER WELL DRILLERS LOG

Nov 14 1969 Roth Drilling Co Wayne
date well completed — firm name — county well located

LANDOWNER: Claude Jordan

Rt 4 Waynesboro Miss.
(mailing address)

WELL LOCATION:
sec. 7 T 9 (N) (S) R 6 (E) (W)
5 miles N. of Waynesboro
(distance) (direction) (nearest town)

WELL PURPOSE:
(home, irrigation, municipal, industrial) Domestic or Gas

WELL COMPLETION DATA:

(1) diameter (inches) 2"

(2) total depth (feet) 75'

(3) static water level (feet) 60 (below) (above) top of ground.

(4) casing Steel (material), 72' (depth), 2" (size) if telescope see back.

(5) screen 3' (length), 72 (depth to top), 1/4" (size), 8 slot S.S. (material)

(6) pump 1 (HP) 8 (yield gpm) elec. (type power)

(7) electric log no (yes or no)

(organization running log)

(8) how well bottom plugged Sand Gravel

DRILLERS REMARKS:

description of formations encountered	from	to
red clay	0	10
sand &	10	75
shale	75	76
3' 1/4" 8 slot	S.S	
Screened on Gas		

DEC - 1 1969

MISS. BD. OF WATER COMM.

If well telescopes please sketch and show depths.

GROUND LEVEL

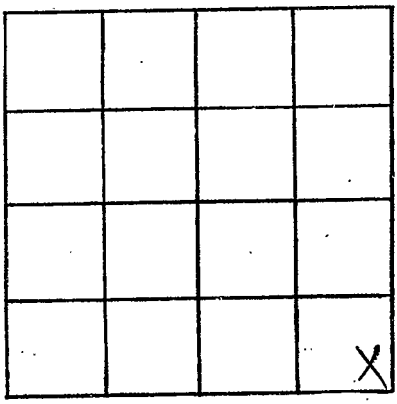

SECTION 7

Please indicate well location X.

ADDITIONAL INFORMATION

If more than one screen, show locations of each on sketch.