WAYNE
J 2049

MISSISSIPPI
BOARD OF WATER COMMISSIONERS
416 North State Street
Jackson, Mississippi 39201

WATER WELL DRILLERS LOG

7/28 1988 CARR'S WELL SER. WAYNE
date well completed — firm name — county well located

LANDOWNER: ROBERT SAINS
R.T. 2
WAYNESBORO MS. 39367
(mailing address)

WELL LOCATION:
sec. 29 T. 9 (N) S R. 6 E (W)
5 miles (distance) E (direction) of WAYNESBORO (nearest town)

WELL PURPOSE:
(home, irrigation, municipal, industrial)

WELL COMPLETION DATA:
(1) diameter (inches) 2
(2) total depth (feet) 75
(3) static water level (feet) 49 below above top of ground.
(4) casing PVC (material), 70 (depth),
2" (size) If telescope see back.
(5) screen 5' (length), 70 (depth to top)
2" (size), PVC (material)
(6) pump 1 (HP) 7 (yield gpm)
ELEC (type power)
(7) electric log NO (yes or no)
(organization running log)
(8) how well bottom plugged BACK WASH VALVE

DRILLERS REMARKS:

description of formations encountered	from	to
TOP SOIL	0	1
SAND	1	28
SD + CLAY	28	32
CLAY	32	33
SD. + CLAY	33	36
YLW SD, MED. TO CR.	36	52
MED. TO CR. SAND	52	75

RECEIVED
SEP 07 1988
Department of Natural Resources
Bureau of Land & Water Resources

If well telescopes please sketch and show depths.

GROUND LEVEL

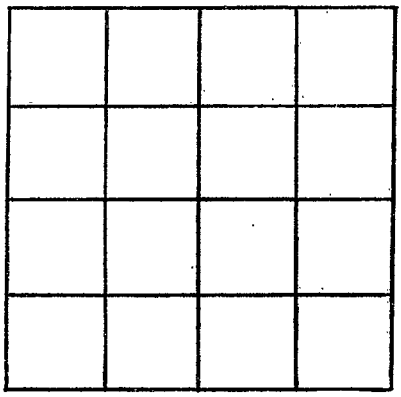

SECTION _____

Please indicate well location X.

ADDITIONAL INFORMATION

If more than one screen, show locations of each on sketch.