Wayne
L37
3-17-72

MISSISSIPPI
BOARD OF WATER COMMISSIONERS
416 North State Street
Jackson, Mississippi 39201

WATER WELL DRILLERS LOG

CODED

Mar 17 1972 Roy West Water Wells Wayne
date well completed firm name county well located

LANDOWNER: Russell Dawson
Rt 1 Waynesboro
(mailing address)

WELL LOCATION: SE/SE
sec. 14 T 8 N/S R 9 E/W
15 (distance) miles E (direction) of Laurel (nearest town)

WELL PURPOSE: Home
(home, irrigation, municipal, industrial)

WELL COMPLETION DATA:

(1) diameter (inches) 2
(2) total depth (feet) 103
(3) static water level (feet) 55 below above top of ground.
(4) casing Plastic (material), 98 (depth),
(size) if telescope see back.
(5) screen 10 (length), 93 (depth to top)
2 (size), Plastic (material)
(6) pump 1 (HP) 5 (yield gpm)
Rea (type power)
(7) electric log No (yes or no)
(organization running log)
(8) how well bottom plugged Washed

DRILLERS REMARKS:

description of formations encountered	from	to
Clay	0	4
Sandy clay	4	35
Clay	35	85
Sand	85	103

CODED

MAY 2 - 1972
MISS. DEPT. OF WATER COMMISSIONERS

If well telescopes please sketch and show depths.

GROUND LEVEL

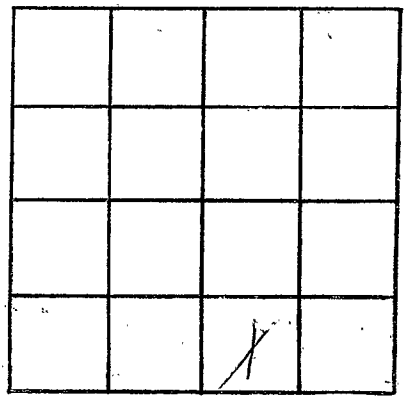

SECTION 14

Please indicate well location X.

ADDITIONAL INFORMATION

If more than one screen, show locations of each on sketch.