Wayne
M73
8-28-69

MISSISSIPPI
BOARD OF WATER COMMISSIONERS
416 North State Street
Jackson, Mississippi 39201

CODED

WATER WELL DRILLERS LOG

Aug 28 1969 [illegible] Drilling Co. Wayne
date well completed — firm name — county well located

LANDOWNER: Mrs Willie Harrison 4003 Grandview Ave. Meridian
(mailing address)

WELL LOCATION:
sec. 11 T 8 (N) S R 8 (E) W
7 miles east of Waynesboro
(distance) (direction) (nearest town)

WELL PURPOSE: Home
(home, irrigation, municipal, industrial)

WELL COMPLETION DATA:
(1) diameter (inches) 2"
(2) total depth (feet) 90'
(3) static water level (feet) 81 (below) above top of ground.
(4) casing steel (material), 84' (depth), 2" (size) if telescope see back.
(5) screen 5' (length), 85 (depth to top), 1¼" (size), bolt S.S. (material)
(6) pump ½ hd (HP) 3½ (yield gpm) elec. (type power)
(7) electric log no (yes or no)
(organization running log)
(8) how well bottom plugged [illegible]

DRILLERS REMARKS:

description of formations encountered	from	to
red clay	0	5
sand	5	47
shale	47	62
sand	62	84
medium sand to		
fine gravel white	84	90
strong white		
water still in sand		
5' 1¼ bolt S.S.		
well 2' 1¼" lap joint		
tester with cylinder		

SEP 24 1969
MISS. BD. OF WATER COMM.

If well telescopes please sketch and show depths.

GROUND LEVEL

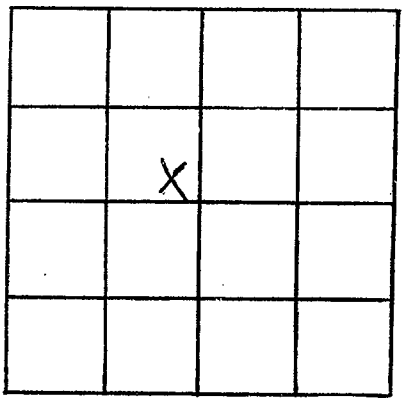

SECTION 11

Please indicate well location X.

ADDITIONAL INFORMATION

If more than one screen, show locations of each on sketch.