WAYNE
M 2008
1/11/78

MISSISSIPPI BOARD OF WATER COMMISSIONERS
416 North State Street
Jackson, Mississippi 39201

WATER WELL DRILLERS LOG

Jan 11 1978 Porter Drilling Co. Wayne
date well completed — firm name — county well located

LANDOWNER: Hance Loper

Rt 4 Laurel Miss.
(mailing address)

WELL LOCATION:
sec. 2 T. 8 (N) S R. 8 E (W)
6 miles W of Waynesboro
(distance) (direction) (nearest town)

WELL PURPOSE: Rom & shop
(home, irrigation, municipal, industrial)

WELL COMPLETION DATA:
(1) diameter (inches) 2"
(2) total depth (feet) 105'
(3) static water level (feet) 48 (below) above top of ground.
(4) casing PVC (material), 100' (depth), 2" (size) if telescope see back.
(5) screen 5' (length), 100' (depth to top), 1 1/4" (size), 6 slot S.S. (material)
(6) pump 3/4 (HP) 7 (yield gpm)
elec (type power)
(7) electric log no (yes or no)
(organization running log)
(8) how well bottom plugged 1 1/4" back wash valve

DRILLERS REMARKS:

description of formations encountered	from	to
red clay & sand	0	20
white coarse sand	20	35
sand some clay	35	52
clay some sand	52	69
clay	69	72
sand some clay	72	90
sand rock &	90	91
coarse sand	91	105
shoreline sand & clay		
5' 1 1/4" 6 slot S.S. screen with 1 1/4" back wash valve on end & shell trap above		
73' 1" PVC drop pipe		

RECEIVED
JAN 27 1978
MISS. BD. OF WATER COMM.

If well telescopes please sketch and show depths.

GROUND LEVEL

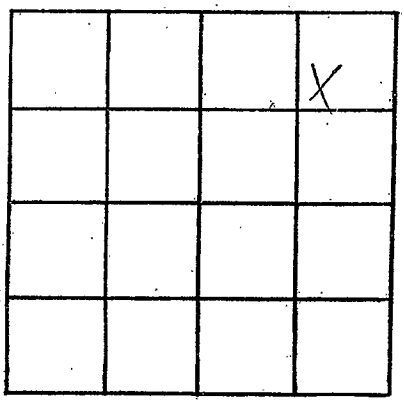

SECTION 2

Please indicate well location X.

ADDITIONAL INFORMATION

If more than one screen, show locations of each on sketch.