

N 11

10-25-63

WATER WELL DRILLERS LOG

Date: Oct 25, 1963, Driller: Porter Drilling & Pipe Co. Wayne
 (Name)

(1) Owner of Land: Jimmy West
 (Name)
Rt 3 Waynesboro
 (Address)

(2) Location: SW 1/4, SW 1/4, Sec. 2 T8 R7
1 miles west, of Waynesboro
 (distance) (direction) (Nearest Town)

(3) Topography: flat
 (Hilly) (Flat) (Level)

(4) Purpose of Well: domestic
 (Domestic Irrigation
 Municipal, Industrial, Other)

| Description & Color of Materials Sand, Clay, Red Clay, Shell, etc. | Thick- ness Feet | Depth Feet |
|---|------------------------|---------------|
| <u>sand</u> | <u>18</u> | <u>18</u> |
| <u>brown clay</u> | <u>16</u> | <u>34</u> |
| <u>thin rocks + shale</u> | <u>12</u> | <u>46</u> |
| <u>blue chalk</u> | <u>4</u> | <u>50</u> |
| <u>hard lime rock</u> | <u>7</u> | <u>57</u> |
| <u>soft rock</u> | <u>7</u> | <u>64</u> |
| <u>blue chalk</u> | <u>39</u> | <u>103</u> |
| <u>limestone rock</u> | <u>30</u> | <u>133</u> |
| <u>white chalk</u> | <u>4</u> | <u>137</u> |

Information upon completion of well:

(1) Diameter 2" inches.


(2) Total Depth 137 feet.

(3) Water Level 22' feet below top of ground.

(4) Cased to 103, Size 2"

(5) Screen: Size none, Length _____

(6) Were any formations sealed against pollution?
 _____ yes, no.

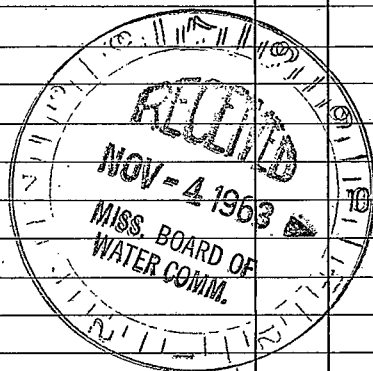

If YES depth of formation _____

Why _____

Drillers Remarks: _____

(Use Back Side)

Well No.





