

035

2-23-65 WATER WELL DRILLERS LOG

Date: Feb 23, 1965, Driller: Boutwell Drilling & Sup County: Wayne
(Name)

Bud Smith well

(1) Owner of Land: Inland Clark
(Name)

Harperston, Miss.
(Address)

(2) Location: NW 1/4, NE 1/4, Sec. 6 T7 R6,

1 miles NE, of Harperston
(distance) (direction) (Nearest Town)

(3) Topography: hilly
(Hilly) (Flat) (Level)

(4) Purpose of Well: domestic
(Domestic Irrigation
Municipal, Industrial, Other)

Description & Color of Materials Sand, Clay, Red Clay, Shell, etc.	Thick- ness Feet	Depth Feet
<u>coarse sand</u>	<u>18</u>	<u>18</u>
<u>chert & gang</u>	<u>12</u>	<u>30</u>
<u>sand & chert</u>	<u>9</u>	<u>39</u>
<u>cherty sand</u>	<u>6</u>	<u>45</u>

Information upon completion of well:

(1) Diameter 2' inches.

(2) Total Depth 45' feet.

(3) Water Level 21' feet below top of ground.

(4) Cased to 37 1/2', Size 2"


(5) Screen: Size 1 1/4", Length 5'
Johnson S.S.

(6) Were any formations sealed against pollution?
no

If YES depth of formation _____

Why _____

Drillers Remarks: _____

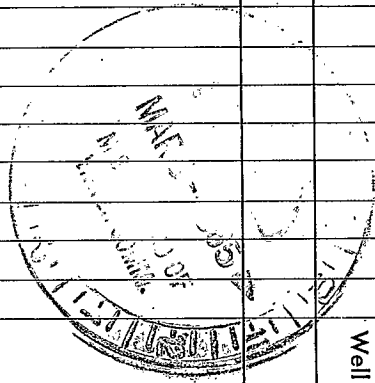

(Use Back Side)

Well No.




