

057

10-18-62

WATER WELL DRILLERS LOG

Date: Oct 18, 1962, Driller: Porter Drilling & Sup. Co. Inc. Jayne
 (Name)

- (1) Owner of Land: Ralph Mosely
 (Name)
Rt 4 Noyesboro, Miss.
 (Address)
- (2) Location: NW 1/4, NW 1/4, Sec. 13, T8R6
7 miles east of Noyesboro
 (distance) (direction) (Nearest Town)
- (3) Topography: Hilly
 (Hilly) (Flat) (Level)
- (4) Purpose of Well: domestic
 (Domestic Irrigation Municipal, Industrial, Other)

Description & Color of Materials Sand, Clay, Red Clay, Shell, etc.	Thick- ness Feet	Depth Feet
<u>red clay</u>	<u>20</u>	<u>20</u>
<u>gray mud & sand</u>	<u>6</u>	<u>26</u>
<u>white chalk</u>	<u>39</u>	<u>65</u>
<u>chick & red sand</u>	<u>13</u>	<u>78</u>
<u>course red sand</u>	<u>3</u>	<u>81</u>
<u>course white sand</u>	<u>6</u>	<u>87</u>
<u>stopped on red sand</u>		


Information upon completion of well:

- (1) Diameter 2" inches.
- (2) Total Depth 87' feet.
- (3) Water Level 64 feet below top of ground.
- (4) Cased to 71, Size 2"
- (5) Screen: Size 1 1/4", Length 6'
- (6) Were any formations sealed against pollution?
 yes, no.

If YES depth of formation _____

Why _____

Drillers Remarks: _____

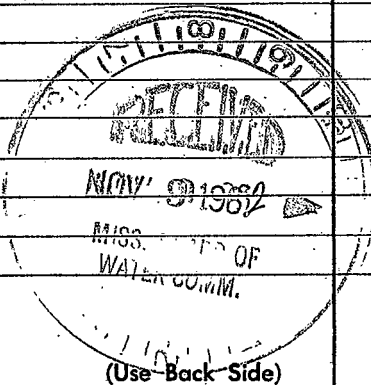

Well No.




