WAYNE
Ø 169
12-72

MISSISSIPPI
BOARD OF WATER COMMISSIONERS
416 North State Street
Jackson, Mississippi 39201

CODED

WATER WELL DRILLERS LOG

Dec 1972 Peoples Drilling Co Wayne
date well completed — firm name — county well located

LANDOWNER: John Goodwin
Rt 2 Box 12 J
Waynesboro, Miss
(mailing address)

WELL LOCATION:
sec. 9 T 8 (N) S R 6 E (W)
4 miles E of Waynesboro
(distance) (direction) (nearest town)

WELL PURPOSE: HOME
(home, irrigation, municipal, industrial)

WELL COMPLETION DATA:
(1) diameter (inches) 4"
(2) total depth (feet) 260
(3) static water level (feet) 96 (below) above top of ground.
(4) casing Iron (material), 147' (depth),
4" (size) if telescope see back.
(5) screen NONE (length), (depth to top)
(size), (material)
(6) pump 1/2 (HP) 10 (yield gpm)
electric (type power)
(7) electric log no (yes or no)
(organization running log)
(8) how well bottom plugged open

DRILLERS REMARKS:

description of formations encountered	from	to
Yellow Sandy clay	0	18
Yellow Sandy clay	18	44
Yellow sand	44	82
Blue marl	82	115
Green limey shale	115	141
White lime & Rock	141	232
White limerock & White sand stone	232	260

CODED

If well telescopes please sketch and show depths.

GROUND LEVEL

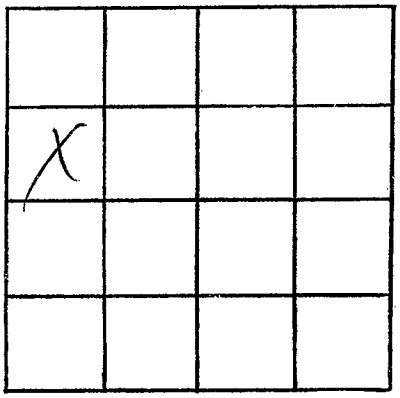

SECTION 9

Please indicate well location X.

ADDITIONAL INFORMATION

If more than one screen, show locations of each on sketch.