WAYNE
Φ 197
4-6-74

MISSISSIPPI
BOARD OF WATER COMMISSIONERS
416 North State Street
Jackson, Mississippi 39201

CODED

WATER WELL DRILLERS LOG

April 6, 1974 19 — McILWAIN WATER WELL SERVICE — WAYNE
date well completed — RT. 2 BOX 37 — county well located
WAYNESBORO, MISS. 39367

LANDOWNER: Mack Hollingshead
Rt 2 Waynesboro
(mailing address)

WELL LOCATION:
sec. 10 T 8 (N) R 6 (W)
3 miles E of W BORO
(distance) (direction) (nearest town)

WELL PURPOSE: HOME
(home, irrigation, municipal, industrial)

WELL COMPLETION DATA:
(1) diameter (inches) 2"
(2) total depth (feet) 83'
(3) static water level (feet) 50' below ~~above~~ top of ground.
(4) casing PVC (material), 73' (depth), 2" (size) if telescope see back.
(5) screen 10' (length), 73' (depth to top), 2" (size), PVC .008 slot (material)
(6) pump 1 (HP) 9 (yield gpm) 220 AC (type power)
(7) electric log no (yes or no)
(organization running log)
(8) how well bottom plugged

DRILLERS REMARKS:

description of formations encountered	from	to
RED CLAY	0	10
YELLOW CLAY	10	14
WHITE CHALK	14	18
SAND ROCK	18	18½
YELLOW CLAY	18½	26
FINE WHITE SAND	26	30
MED SAND AND CLAY STREAKS	30	35
CLAY	35	42
COARSE SAND	42	44
YELLOW CLAY	44	48
LIGHT GREY CLAY	48	63
SAND	63	65
LIGHT GREY CLAY	65	70
MED SAND	70	83

CODED

RECEIVED
MAY - 9 1974
MISS. BD. OF WATER COMM.

If well telescopes please sketch and show depths.

GROUND LEVEL

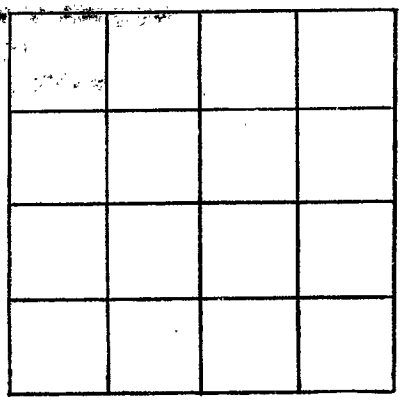

SECTION _____

Please indicate well location X.

ADDITIONAL INFORMATION

If more than one screen, show locations of each on sketch.