Wayne
Ø 2011
3-24-76
13P

MISSISSIPPI
BOARD OF WATER COMMISSIONERS
416 North State Street
Jackson, Mississippi 39201

WATER WELL DRILLERS LOG

MARCH 24, 1976 AD
date well completed

McILWAIN WATER WELL SERVICE
firm name

RT. 2 BOX 37
WAYNESBORO, MISS. 39367

WAYNE
county well located

LANDOWNER:
J. T. TUBBS
WAYNESBORO, MISS.
(mailing address)

WELL LOCATION:
sec. 35 T 8 N R 6 W
5 (distance) miles SE (direction) of W'BORO (nearest town)

WELL PURPOSE: HOME
(home, irrigation, municipal, industrial)

WELL COMPLETION DATA:

(1) diameter (inches) 2"
(2) total depth (feet) 83'
(3) static water level (feet) 66' below ~~above~~ top of ground.
(4) casing PVC (material), 79' (depth), 2" (size) if telescope see back.
(5) screen 4' (length), 79' (depth to top), 2" (size), PVC .008 (material)
(6) pump 1 (HP) 7 (yield gpm) 220 (type power)
(7) electric log No (yes or no)
(organization running log)
(8) how well bottom plugged

DRILLERS REMARKS:

description of formations encountered	from	to
Red Clay	0	12
Sandy Clay	12	15
White Clay	15	28
Sand & Clay	28	32
Sand	32	43
Blue Clay	43	48
fine sand	48	52
Clay	52	63
fine sand	63	70
Med. Sand	70	75
Med. Coarse sand	75	83

RECEIVED
APR 20 1976
MISS. BD. OF WATER COMM.

If well telescopes please sketch and show depths.

GROUND LEVEL

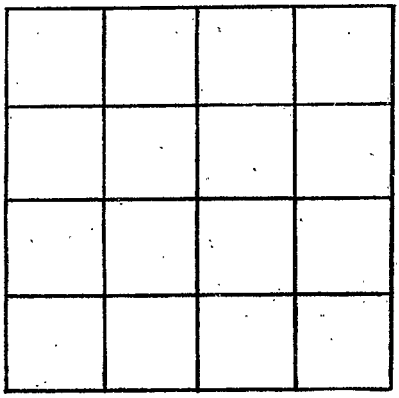

SECTION _____

Please indicate well location X.

ADDITIONAL INFORMATION

If more than one screen, show locations of each on sketch.