Wayne
0
9-25-79

MISSISSIPPI
BOARD OF WATER COMMISSIONERS
416 North State Street
Jackson, Mississippi 39201

WATER WELL DRILLERS LOG

9-25 19 79 McILWAIN WATER WELL SERVICE Wayne
date well completed RT. 2 BOX 37 county well located
WAYNESBORO, MISS. 39367

LANDOWNER:
Edward Holifield
Waynesboro Ms
(mailing address)

WELL LOCATION:
sec 27 T 8 N R 6 W
6 miles SE of W'boro
(distance) (direction) (nearest town)

WELL PURPOSE: Home
(home, irrigation, municipal, industrial)

WELL COMPLETION DATA:

(1) diameter (inches) 2"
(2) total depth (feet) 29'
(3) static water level (feet) 22½' below ~~above~~ top of ground.
(4) casing PVC (material), 29' (depth), 2" (size) if telescope see back.
(5) screen 5' (length), 24' (depth to top), 2" (size), PVC .008 (material)
(6) pump 1 (HP) 9 (yield gpm) 220 AC (type power)
(7) electric log No (yes or no)
(organization running log)
(8) how well bottom plugged

DRILLERS REMARKS:

description of formations encountered	from	to
Red Sand Clay	0	15.5
Red Sand	15.5	20
Coarse White Sand	20	29

DEPT. OF NATURAL RESOURCES
BUREAU OF LAND & WATER RESOURCES
NOV 16 1979
RECEIVED

If well telescopes please sketch and show depths.

GROUND LEVEL

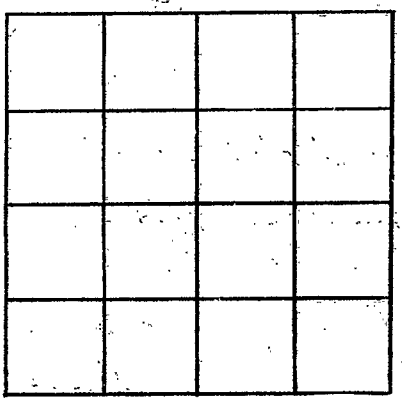

SECTION _____

Please indicate well location X.

ADDITIONAL INFORMATION

If more than one screen, show locations of each on sketch.