MISSISSIPPI DEPARTMENT OF ENVIRONMENTAL QUALITY
Bureau of Land and Water Resources

P. O. Box 10631
Jackson, MS 39289-0631
WATER WELL DRILLERS LOG

COUNTY WELL LOCATED: Wayne
WELL NUMBER: 4 | CODED:
DATE WELL COMPLETED: 2-27-92

PERMIT NUMBER: 0-205
NAME OF DRILLING FIRM: CARRS Well Service

NAME & MAILING ADDRESS OF LANDOWNER
Weeks Exploration Company
A Subsidiary of Peko LTD
1100 Milam Suite 4230
Houston TX 77002-6499

WELL LOCATION: SEC 9 TOWNSHIP 8 (N) S RANGE 6 (E) W

DISTANCE 3½ Miles DIRECTION East of NEAREST TOWN Wabo

OTHER LANDMARK

WELL PURPOSE: Home, Irrigation, Municipal, (Industrial), Fish Pond, etc.

PUMP DATA

PUMP TYPE (Circle One): (Submersible), Turbine, Jet, Flowing Well, Other (Describe)

POWER TYPE (Circle One): Electric, Tractor, Diesel, Gasoline, Butane, Other (Describe) H/P 1½

Pump Capacity (GPM)	No. of Stages	Setting Depth
26	10	180 FT.

PUMP TEST
Well yielded 25 GPM with a drawdown of 60 ft. after 3 hours of pumping (When Pumping)

WELL DATA

Well Depth	Casing Diameter (In.)	Casing Length (Ft.)
240	4	193

Type of Casing	Hole Depth	Depth to Static Water Level
PVC	295	90

TYPE OF COMPLETION: (Circle One or More): Gravel Packed, Underreamed, Telescoped, Natural Development, (Open Hole), Other (Describe)

Top of Lap Pipe or Reduction in Casing FEET

IF TELESCOPED OR MORE THAN ONE SCREEN: USE BACK PAGE

SCREEN DATA

Diameter - Inches	Length - Feet	Slot Size - Inches
N/A		

Screen Type	Depth to Bottom - Feet

LOG DATA

TYPE OF LOG RUN (Circle One): No Log Run, Electric, Gamma Ray, Density, Sonic, Neutron, Other (Describe)

Name of Organization Running Log

GEOLOGIC DATA (Office Use Only)

Surface Elev	Geologic Units	Unit Thickness	Depth to Top
Subs. SWL	Date	Analysis	Aquifer Test

Driller's Remarks

RECEIVED
MAR 16 1992
Dept. of Environmental Quality
Bureau of Land & Water Resources

DESCRIPTION OF FORMATIONS ENCOUNTERED	FROM	TO
Pink & white CLAY	0	5
White & Yellow CLAY	5	13
ROCK	13	14
BROKEN SAND & CLAY	14	25
GRAY CLAY	25	40
FINE FINE SAND	40	43
BLUE CLAY	43	64
FINE FINE SAND	64	66
BLUE CLAY	66	87
ROCK	87	89
BLUE CLAY	89	95

FORMATIONS (Continued)	FROM	TO
ROCK	95	97
BLUE CLAY	97	110
ROCK STRATORS	110	130
GRAY CLAY	130	193
ROCK (CAPROCK SAND)	193	230
BLUE CLAY	230	295

IF MORE SPACE IS NEEDED, USE BACK

If well telescopes please sketch and show depths.

GROUND LEVEL

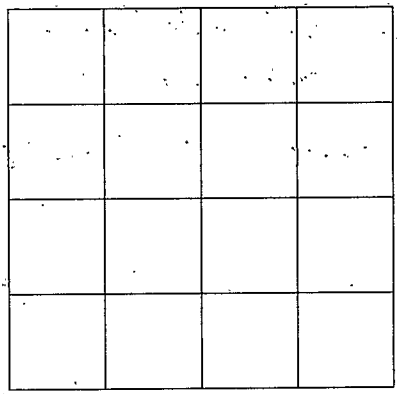

SECTION _____

Please indicate well location X.

ADDITIONAL INFORMATION

If more than one screen, show location of each on sketch.