WAYNE
P42
8-14-72

MISSISSIPPI
BOARD OF WATER COMMISSIONERS
416 North State Street
Jackson, Mississippi 39201

CODED

WATER WELL DRILLERS LOG

Aug. 14 19 72 Rison Water Well Ser. Wayne
date well completed — firm name — county well located

LANDOWNER: R.L. Lassater
Rt 2 Waynesboro, Miss
(mailing address)

WELL LOCATION:
sec. 29 T 8 (N/S) R 5 (E/W)
4 miles (distance) Southeast (direction) of Denham (nearest town)

WELL PURPOSE: Home
(home, irrigation, municipal, industrial)

WELL COMPLETION DATA:

(1) diameter (inches) 4"
(2) total depth (feet) 86'
(3) static water level (feet) 42' (below/above) top of ground.
(4) casing 2" (material), 83' (depth),
_____ (size) if telescope see back.
(5) screen 3' (length), 86' (depth to top)
1½' (size), Brass Coated (material)
(6) pump 1 (HP) 8 (yield gpm)
Electric (type power)
(7) electric log no. (yes or no)
_____ (organization running log)
(8) how well bottom plugged Drive Point

DRILLERS REMARKS: Good

description of formations encountered	from	to
Top soil	0	2
Red Clay	2	10
White Chalk	10	25
Chalk sand	25	30
White & Red Clay	30	40
Fine sand	40	45
Blue Chalk	45	62
Fine sand	62	72
Coarse sand	72	86
Total	86	Feet

CODED

SEP 5 1972

If well telescopes please sketch and show depths.

GROUND LEVEL

If more than one screen, show locations of each on sketch.

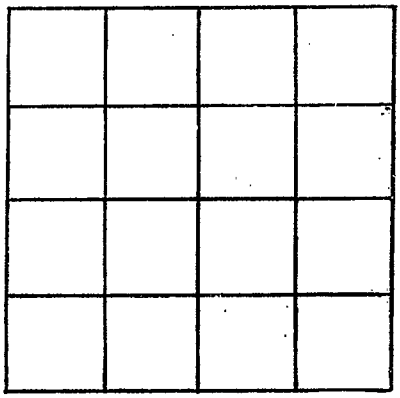

SECTION _____

Please indicate well location X.

ADDITIONAL INFORMATION