

WAYNE MISSISSIPPI BOARD OF WATER COMMISSIONERS

S 25

12-20-62 WATER WELL DRILLERS LOG

Date: Dec 20, 1962, Driller: Porter Drilling & Exp County Wayne
 (Name)

(1) Owner of Land: Robert Watts
 (Name)

Rt 3 Waynesboro
 (Address)

(2) Location: NE 1/4, NW 1/4, Sec. 2 T7R7

5 miles south, of Waynesboro
 (distance) (direction) (Nearest Town)

(3) Topography: hilly
 (Hilly) (Flat) (Level)

(4) Purpose of Well: domestic
 (Domestic Irrigation Municipal, Industrial, Other)

Information upon completion of well:

(1) Diameter: 2" inches.

(2) Total Depth: 114' feet.

(3) Water Level: 87' feet below top of ground.

(4) Cased to: 98', Size: 2"

(5) Screen: Size 1 1/4", Length 5'

Johnson S. S.

(6) Were any formations sealed against pollution?


yes, no.

If YES depth of formation _____

Why _____

Drillers Remarks: _____

Description & Color of Materials Sand, Clay, Red Clay, Shell, etc.	Thick- ness Feet	Depth Feet
red clay	18	18
cherty sand	22	40
blue chert	57	97
rock	2	97.5
red sand with streak of white sand in middle	16.5	114

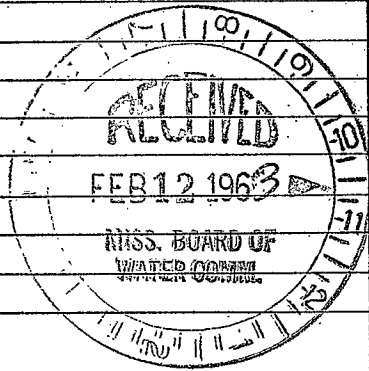

(Use Back Side)

Well No.




