

S 28
8-29-62

WATER WELL DRILLERS LOG

Date: Aug 29, 1962, Driller: Porter Drilling & Rep County Wayne
(Name)


(1) Owner of Land: <u>Clifford Cochran</u> (Name) <u>Pt 3 Haynesboro</u> (Address)	Description & Color of Materials Sand, Clay, Red Clay, Shell, etc.	Thick-ness Feet	Depth Feet
	<u>red clay & sand</u>	<u>15'</u>	<u>15'</u>
(2) Location: <u>SE 1/4, NW 1/4, Sec. 8 T. 7 R. 7</u> <u>1 1/2</u> miles <u>west</u> of <u>Clara</u> (distance) (direction) (Nearest Town)	<u>sand</u>	<u>13'</u>	<u>28'</u>
(3) Topography: <u>hilly</u> (Hilly) (Flat) (Level)			
(4) Purpose of Well: <u>domestic</u> (Domestic Irrigation Municipal, Industrial, Other)			

Information upon completion of well:

- (1) Diameter 2' inches.
- (2) Total Depth 28' feet.
- (3) Water Level 12' feet below top of ground.
- (4) Cased to 22', Size 2"
- (5) Screen: Size 1 1/4", Length 6'
- (6) Were any formations sealed against pollution?
_____ yes, X no.

If YES depth of formation _____
Why _____

Drillers Remarks: _____

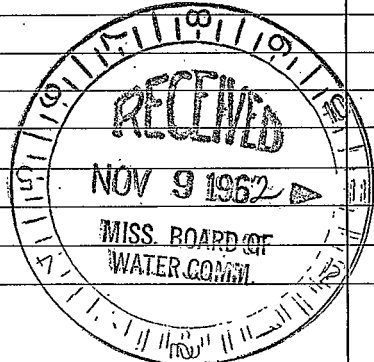

(Use Back Side)

Well No.







