

S30

12-30-60

WATER WELL DRILLERS LOG

*303*

Date: Dec 30, 19 60, Driller: D. N. Porter & Son County Wayne  
 (Name)


(1) Owner of Land: <u>Wayne County School Sys.</u> <small>(Name)</small>	Description & Color of Materials Sand, Clay, Red Clay, Shell, etc.	Thick- ness Feet	Depth Feet
<u>Wayne County, Miss.</u> <small>(Address)</small>	<u>clay</u>	10'	10'
(2) Location: <u>NE 1/4, SE 1/4, Sec. 9 T7R7,</u>	<u>sand</u>	10'	20
<u>_____</u> miles, of <u>Clara</u> <small>(distance) (direction) (Nearest Town)</small>	<u>chert</u>	20'	40
(3) Topography: <u>Flat</u> <small>(Hilly) (Flat) (Level)</small>	<u>sand</u>	45'	85
(4) Purpose of Well: <u>School</u> <small>(Domestic Irrigation Municipal, Industrial, Other)</small>	<u>chert</u>	20'	105
	<u>sand</u>	49'	154
	<u>sand mixed with strata's</u>		
	<u>of chert</u>	18'	172
	<u>stiff chert</u>	6'	178

Information upon completion of well:

- (1) Diameter 2" inches.
- (2) Total Depth 148' feet.
- (3) Water Level 20' feet below top of ground.
- (4) Cased to 126, Size 2"
- (5) Screen: Size 2", Length 20'  
stainless steel
- (6) Were any formations sealed against pollution?  
\_\_\_\_\_ yes, X no.

If YES depth of formation \_\_\_\_\_  
 Why \_\_\_\_\_

Drillers Remarks: \_\_\_\_\_  
 \_\_\_\_\_  
 \_\_\_\_\_

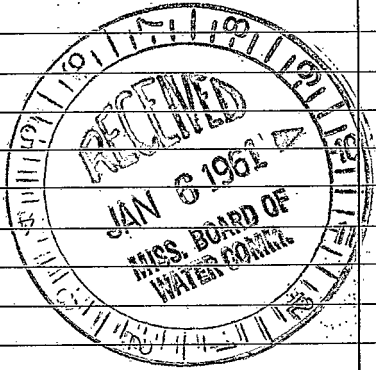

(Use Back Side)

Well No.




