

WAYNE MISSISSIPPI BOARD OF WATER COMMISSIONERS

S34

6-20-64

WATER WELL DRILLERS LOG

Date: June 20, 1964, Driller: Porter Drilling & Log County Wayne
 (Name)

(1) Owner of Land: Pat Harrison
 (Name)
At 3 Waynesboro, Miss.
 (Address)

(2) Location: NW 1/4, SW 1/4, Sec 10 T 7 R 7
1/2 miles NE of Clara
 (distance) (direction) (Nearest Town)

(3) Topography: hilly
 (Hilly) (Flat) (Level)

(4) Purpose of Well: domestic
 (Domestic Irrigation
 Municipal, Industrial, Other)

Description & Color of Materials Sand, Clay, Red Clay, Shell, etc.	Thick- ness Feet	Depth Feet
<u>clay & chalk</u>	<u>20</u>	<u>20</u>
<u>blue chalk</u>	<u>28</u>	<u>48</u>
<u>fine sand & chalk</u>	<u>10</u>	<u>58</u>
<u>red med sand</u>	<u>9</u>	<u>67</u>
<u>blue sand</u>	<u>2</u>	<u>69</u>
<u>would not clean up in bottom of sand</u>		

Information upon completion of well:

(1) Diameter 2" inches.

(2) Total Depth 65' feet.

(3) Water Level 41 feet below top of ground.

(4) Cased to 59', Size 2"


(5) Screen: Size 1 1/4, Length 6'
60 ga

(6) Were any formations sealed against pollution?
 _____ yes, X no.

If YES depth of formation _____

Why _____

Drillers Remarks: _____

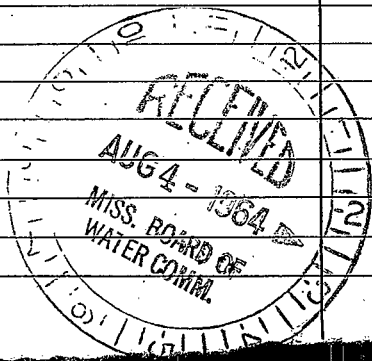

Well










