WAYNE
T 8003
1-19-76

13P

MISSISSIPPI
BOARD OF WATER COMMISSIONERS
416 North State Street
Jackson, Mississippi 39201

WATER WELL DRILLERS LOG

Jan 19, 1976 19 McILWAIN WATER WELL SERVICE WAYNE
date well completed — firm name — county well located

RT. 2 BOX 37
WAYNESBORO, MISS. 39367

LANDOWNER:
Eloise Powe
Rt 4 Waynesboro, Miss.
(mailing address)

WELL LOCATION:
sec. 2 T. 7 N & R. 6 E W
6 (distance) miles SE (direction) of W'BORO (nearest town)

WELL PURPOSE: HOME
(home, irrigation, municipal, industrial)

WELL COMPLETION DATA:

(1) diameter (inches) 2"
(2) total depth (feet) 48'
(3) static water level (feet) 12' below ~~above~~ top of ground.
(4) casing PVC (material), 43' (depth), 2" (size) if telescope see back.
(5) screen 5' (length), 43' (depth to top), 2" (size), PVC .008 (material)
(6) pump 1 (HP) 12 (yield gpm)
220 AC (type power)
(7) electric log no (yes or no)
(organization running log)
(8) how well bottom plugged

DRILLERS REMARKS:

description of formations encountered	from	to
Red Clay	0	5
Mixed Clay	5	14
Coarse Sand	14	18
Med Sand	18	29
Clay	29	32
Sand	32	48

RECEIVED
JAN 26 1976
MISS. BD. OF WATER COMM

If well telescopes please sketch and show depths.

GROUND LEVEL

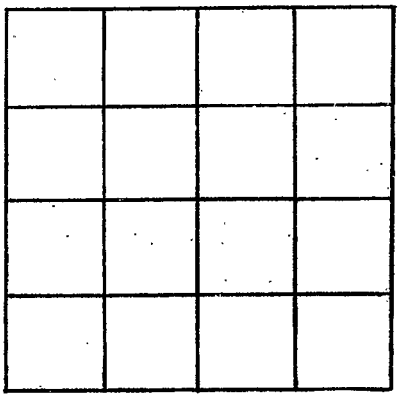

SECTION _____

Please indicate well location X.

ADDITIONAL INFORMATION

If more than one screen, show locations of each on sketch.