Wayne
P 2022
7-13-81

MISSISSIPPI DEPARTMENT OF NATURAL RESOURCES
Bureau of Land and Water Resources
Southport Mall
P.O. Box 10631
Jackson, Mississippi 39209

WATER WELL DRILLERS LOG

July 13 1981 Porter Drilling Co. Wayne
date well completed firm name county well located

LANDOWNER: Frank Ward
P.O. Box 45
Buckatunna Miss
(mailing address)

WELL LOCATION:
sec. 6 T 6 N S R 6 E W
6 miles S of Chicora
(distance) (direction) (nearest town)

WELL PURPOSE: Chicken house
(home, irrigation, municipal, industrial)

WELL COMPLETION DATA:

(1) diameter (inches) 2"
(2) total depth (feet) 163
(3) static water level (feet) 76 below above top of ground.
(4) casing PVC (material), 158' (depth)
2" (size) If telescope see back.
(5) screen 5' (length), 158' (depth to top)
2" (size), 6 slot SS (material)
(6) pump 1 (HP) 8 (yield gpm)
elec (type power)
(7) electric log no (yes or no)
(organization running log)
(8) how well bottom plugged? 2' sand, chunk,

DRILLERS REMARKS:
Shelting above Screen

description of formations encountered	from	to
Clay	0	6
Sand	6	18
Clay	18	83
fine sand & clay	83	108
Clay	108	131
sand	131	135
Clay	135	143
Clay & sand	143	155
med. clean sand	155	163
shale on clay		
95' 1" PVC drop pipe		

DEPT. OF NATURAL RESOURCES
BUREAU OF LAND & WATER RESOURCES
JUL 22 1981
RECEIVED

If well telescopes please sketch and show depths.

GROUND LEVEL

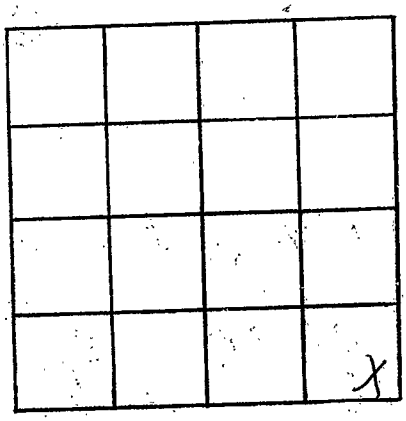

SECTION 16

Please indicate well location X.

ADDITIONAL INFORMATION

If more than one screen, show locations of each on sketch.