Webster
A10
6-69
MGS

CODED

MISSISSIPPI
BOARD OF WATER COMMISSIONERS
416 North State Street
Jackson, Mississippi 39201

WATER WELL DRILLERS LOG

June 19 69 Robert E. Ratliff Co. Webster
date well completed — firm name — county well located

LANDOWNER: Cadaretta Water Association, Inc.
Cadaretta, Mississippi
(mailing address)

WELL LOCATION:
sec. 10 T. 21 N R. 8 E

NE 1/4 miles NW 1/4 of SE 1/4
(distance) (direction) (nearest town)
Grenada & Tupopa Road

WELL PURPOSE:
(home, irrigation, municipal, industrial)

WELL COMPLETION DATA:

(1) diameter (inches) 8"

(2) total depth (feet) 280'

(3) static water level (feet) 69 below above top of ground.

(4) casing Steel (material), 220' (depth),
_____ (size) if telescope see back.

(5) screen 60' (length), 200? (depth to top)
4" (size), S.S. Screen (material)

(6) pump 7 1/2 (HP) 71 (yield gpm)
Electric (type power)

(7) electric log yes (yes or no) (USGS elog #20)
State (organization running log)

(8) how well bottom plugged B.P.V.

DRILLERS REMARKS:

description of formations encountered	from	to
Top Soil Sand	0	20
Sand & Clay	20	40
Sand & Clay	40	58
Clay	58	62
Sand & Clay	62	71
Sand (Course)	71	133
Sand & Clay	133	164
Sand	164	167
Sand & Clay	167	216
Sand	216	239
Clay	239	242
Sand	242	245
Sand Clay	245	246
Sand Fine	246	293

JAN - 9 1970
MISS. BD. OF WATER COMM.

If well telescopes please sketch and show depths.

GROUND LEVEL

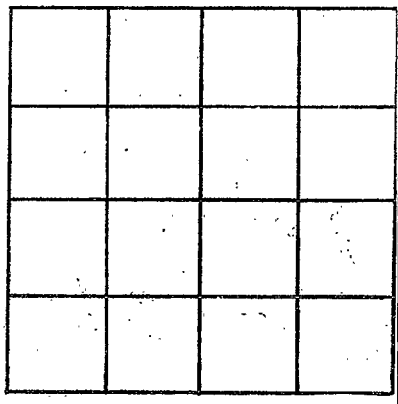

SECTION _____

Please indicate well location X.

ADDITIONAL INFORMATION

If more than one screen, show locations of each on sketch.