

CODED

G 12
4-20-62

WATER WELL DRILLERS LOG

Date: 4/20/62, Driller: L. K. Merritt County Webster
(Name)

(1) Owner of Land: J. C. Hoggman
(Name)
Lempira Miss
(Address)

(2) Location: 26 20 9
4 miles NW of LEMPORA
(distance) (direction) (Nearest Town)

(3) Topography: (Hilly) (Flat) (Level)

(4) Purpose of Well: Domestic
(Domestic Irrigation
Municipal, Industrial, Other)

Description & Color of Materials Sand, Clay, Red, Clay, Shell, etc.	Thick- ness Feet	Depth Feet
0-75 - <u>Surface Clay</u>	0	0
<u>Blue Clay</u>	15	15
<u>Blue Clay & Shale</u>	42	172
<u>Trace of fine blue sand below 126'</u>		

Information upon completion of well:

(1) Diameter 2 inches.

(2) Total Depth 172 feet.

(3) Water Level 100 feet below top of ground.

(4) Cased to 126, Size 2


(5) Screen: Size Open, Length _____

(6) Were any formations sealed against pollution?
 yes, no.

If YES depth of formation 2 Traps
Why at 126'

Drillers Remarks:

Coded by [unclear] 4-11-62

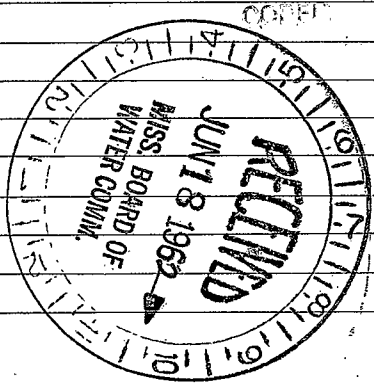

(Use Back Side)

Well No.







