

WATER WELL DRILLERS LOG

J 11  
10-29-62

CODED

Date: 10.29, 1962, Driller: J.L. Merritt County WINSTON

(Name)

(1) Owner of Land: R.P. Gilliland  
(Name)

MATHISTON, MISS.  
(Address)  
21 20N11W

(2) Location: 1/4, 1/4, Sec. T R  
2 miles north of MATHISTON  
(distance) (direction) (Nearest Town)

(3) Topography:  (Hilly)  (Flat)  (Level)

(4) Purpose of Well: Domestic  
(Domestic Irrigation, Municipal, Industrial, Other)

Description & Color of Materials Sand, Clay, Red Clay, Shell, etc.	Thick- ness Feet.	Depth Feet
Red clay	0	21
lignite	21	28
White sand	28	36

rocked but  
not located.  
JES

CODED

Information upon completion of well:

(1) Diameter 2 inches.

(2) Total Depth 40 feet.

(3) Water Level 25 feet below top of ground.

(4) Cased to 29, Size 2"

(5) Screen: Size 1 1/4, Length 6 ft.


(6) Were any formations sealed against pollution?

yes,  no.

If YES depth of formation

Why

Drillers Remarks:

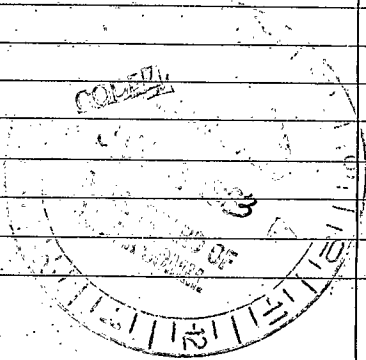

(Use Back Side)

Well No.












