MISSISSIPPI DEPARTMENT OF NATURAL RESOURCES

Bureau of Land and Water Resources

P.O. Box 10631
Jackson, Mississippi 39209

WATER WELL DRILLERS LOG

COUNTY WELL LOCATED: Wilkinson	PERMIT NUMBER
WELL NUMBER: A	CODED
2005	NAME OF DRILLING FIRM: RAYBORN DRILLING, INC.
DATE WELL COMPLETED: 9-7-88	Rt 5 Box 98 Natchez MS 39120

NAME & MAILING ADDRESS OF LANDOWNER

D & D Drlg. Co.
P.O. Box 351
Ferriday LA 71334

WELL LOCATION: SEC 39 TOWNSHIP 4 (N) (S) RANGE 3 (E) (W)

DISTANCE 3 Miles DIRECTION W of NEAREST TOWN Doloroso

OTHER LANDMARK

WELL PURPOSE: Home, Irrigation, Municipal, Industrial, Fish Pond, etc.
Oilfield

PUMP DATA

PUMP TYPE (Circle One): Submersible, Turbine, Jet, Flowing Well, Other (Describe) Air

POWER TYPE (Circle One): Electric, Tractor, Diesel, Gasoline, Butane, Other (Describe)

Pump Capacity (GPM)	No. of Stages	Setting Depth
—	—	— FT.

PUMP TEST

Well yielded 50 GPM with a drawdown of _____ ft. after _____ hours of pumping

WELL DATA

Well Depth	Casing Diameter (In.)	Casing Length (Ft.)
100'	3"	90'

Type of Casing	Hole Depth	Depth to Static Water Level
Sch40 PVC	100'	30'

TYPE OF COMPLETION: (Circle One or More): Gravel Packed, Underreamed, Telescoped, Natural Development, Open Hole, Other (Describe)

Top of Lap Pipe or Reduction in Casing FEET

IF TELESCOPED OR MORE THAN ONE SCREEN: USE BACK PAGE

LOG DATA

TYPE OF LOG RUN (Circle One): No Log Run, Electric, Gamma Ray, Density, Sonic, Neutron, Other (Describe)

Name of Organization Running Log

GEOLOGIC DATA (Office Use Only)

Surface Elev.	Geologic Unit	Unit Thickness	Depth to Top
Subs. SWL	Date	Analysis	Aquifer Test

Driller's Remarks

SCREEN DATA

Diameter - Inches	Length - Feet	Slot Size - Inches
3"	10'	.020

Screen Type	Depth to Bottom - Feet
Sch 40 Slotted PVC	100'

DESCRIPTION OF FORMATIONS ENCOUNTERED	FROM	TO
Gumbo	0	10
Sand	10	100

FORMATIONS (Continued)	FROM	TO

IF MORE SPACE IS NEEDED, USE BACK

RECEIVED
JAN 03 1989
Department of Natural Resources
Bureau of Land & Water Resources

If well telescopes please
sketch and show depths.

GROUND LEVEL

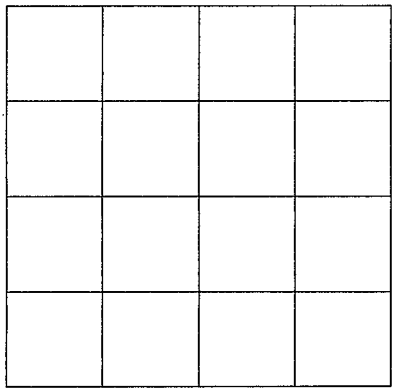

SECTION _____

Please indicate well location X.

ADDITIONAL INFORMATION

If more than one screen,
show location of each on sketch.