Wilkinson
B6
12-67

CODED Central Const. Co.

MISSISSIPPI
BOARD OF WATER COMMISSIONERS
416 North State Street
Jackson, Mississippi 39201

WATER WELL DRILLERS LOG

12-1 1967 Fortenberry Drlg Co. Wilkinson
date well completed — firm name — county well located

LANDOWNER: Sharpe 37-5

Elev 225
(mailing address)

WELL LOCATION:
sec. 37 T 4N N/S R 2W E/W

15 miles North of Woodville
(distance) (direction) (nearest town)

WELL PURPOSE: Supply
(home, irrigation, municipal, industrial)

WELL COMPLETION DATA:

(1) diameter (inches) 6 1/4

(2) total depth (feet) 300'

(3) static water level (feet) 150 below ~~above~~ top of ground.

(4) casing Steel (material), 280' (depth),
_____ (size) if telescope see back.

(5) screen 20' (length), 280' (depth to top)
3 1/2 (size), Slotted Pipe (material)

(6) pump air (HP) _____ (yield gpm)
Butane (type power)

(7) electric log NO (yes or no)
_____ (organization running log)

(8) how well bottom plugged Puddled Clay

DRILLERS REMARKS: _____

description of formations encountered	from	to
Shale	0	40
Sand	40'	60'
Shale	50'	250'
Sand	250	300'

CODED

MAY 13 1968
MISS. BD. OF WATER COMM.

If well telescopes please sketch and show depths.

Elev. 225'

GROUND LEVEL

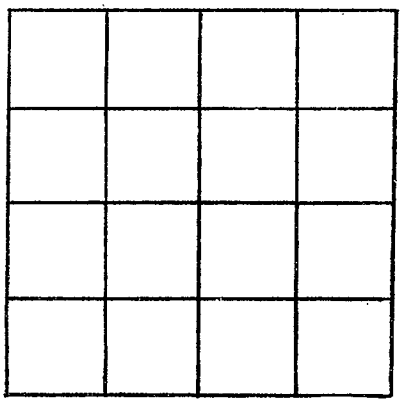

SECTION 37

Please indicate well location. X.

ADDITIONAL INFORMATION

If more than one screen, show locations of each on sketch.