Central Const. Co.

Wilkinson
B8
9-67

CODED

MISSISSIPPI BOARD OF WATER COMMISSIONERS
416 North State Street
Jackson, Mississippi 39201

WATER WELL DRILLERS LOG

9-11 1967 Nevett Hughey Drlg. Co. Wilkinson
date well completed — firm name — county well located

LANDOWNER: Dulaney #1

Elev. 87
(mailing address)

WELL LOCATION:
sec. 36 T 5N N/S R 2 E/W
12 miles S-West of Knoxville
(distance) (direction) (nearest town)

WELL PURPOSE: Supply
(home, irrigation, municipal, industrial)

WELL COMPLETION DATA:

(1) diameter (inches) 6 4/4

(2) total depth (feet) 120'

(3) static water level (feet) 40' below/above top of ground.

(4) casing Steel (material), 110' (depth),
_____ (size) if telescope see back.

(5) screen 10' (length), 110' (depth to top)
3 1/2 (size), Slotted Pipe (material)

(6) pump air (HP) _____ (yield gpm)
Butane (type power)

(7) electric log NO (yes or no)
_____ (organization running log)

(8) how well bottom plugged Puddle Clay

DRILLERS REMARKS: _____

description of formations encountered	from	to
Shale	0	70
Sand	70	120

CODED

MISS. BD. OF WATER COMM.

8

If well telescopes please sketch and show depths.

87'

GROUND LEVEL

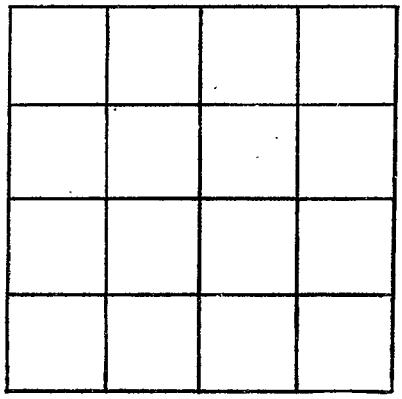

SECTION 36

Please indicate well location X.

ADDITIONAL INFORMATION

If more than one screen, show locations of each on sketch.