CODED

MISSISSIPPI DEPARTMENT OF NATURAL RESOURCES

Bureau of Land and Water Resources

P.O. Box 10631
Jackson, Mississippi 39209

WATER WELL DRILLERS LOG

COUNTY WELL LOCATED: Wilkinson	
WELL NUMBER: D 49	CODED
DATE WELL COMPLETED: 6-10-88	

PERMIT NUMBER

RAYBORN DRILLING, INC.
Rt 5 Box 98
Natchez Ms 39120

NAME & MAILING ADDRESS OF LANDOWNER
Shamrock Drilling
PO Box 2210
Natchez Ms 39120

WELL LOCATION: SEC 27 TOWNSHIP 4 (N) S RANGE 1 (E) W

DISTANCE 2 Miles DIRECTION SW of NEAREST TOWN Rosetta

OTHER LANDMARK

WELL PURPOSE: Home, Irrigation, Municipal, Industrial, Fish Pond, etc.
Oilfield

PUMP DATA

PUMP TYPE (Circle One): Submersible, Turbine, Jet, Flowing Well, Other (Describe) Air

POWER TYPE (Circle One): (Electric), Tractor, Diesel, Gasoline, Butane, Other (Describe)

Pump Capacity (GPM)	No. of Stages	Setting Depth
		FT.

PUMP TEST

Well yielded 50 GPM with a drawdown of _____ ft. after _____ hours of pumping

WELL DATA

Well Depth	Casing Diameter (In.)	Casing Length (Ft.)
300'	3"	10'

Type of Casing	Hole Depth	Depth to Static Water Level
Sch 40 PVC	300'	75'

TYPE OF COMPLETION: (Circle One or More): Gravel Packed, Underreamed, Telescoped, (Natural Development), Open Hole, Other (Describe)

Top of Lap Pipe or Reduction in Casing
FEET

IF TELESCOPED OR MORE THAN ONE SCREEN: USE BACK PAGE

SCREEN DATA

Diameter - Inches	Length - Feet	Slot Size - Inches
3"	10'	.020

Screen Type	Depth to Bottom - Feet
Sch 40 Slotted PVC	300'

LOG DATA

TYPE OF LOG RUN (Circle One): (No Log Run), Electric, Gamma Ray, Density, Sonic, Neutron, Other (Describe)

Name of Organization Running Log

GEOLOGIC DATA (Office Use Only)

Surface Elev.	Geologic Unit	Unit Thickness	Depth to Top
Subs. SWL	Date	Analysis	Aquifer Test

Driller's Remarks

DESCRIPTION OF FORMATIONS ENCOUNTERED	FROM	TO
Clay	0	240
Sand	240	300

FORMATIONS (Continued)	FROM	TO

RECEIVED
JUL 06 1988
Department of Natural Resources
Bureau of Land & Water Resources

IF MORE SPACE IS NEEDED, USE BACK

If well telescopes please
sketch and show depths.

GROUND LEVEL

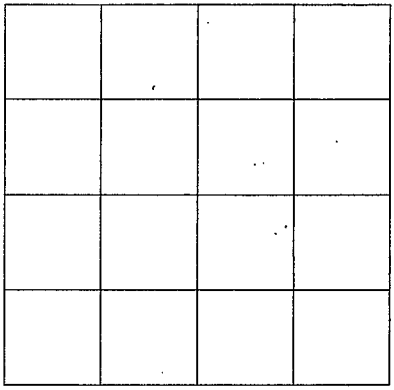

SECTION _____

Please indicate well location X.

ADDITIONAL INFORMATION

If more than one screen,
show location of each on sketch.