MISSISSIPPI DEPARTMENT OF NATURAL RESOURCES

Bureau of Land and Water Resources

P.O. Box 10631
Jackson, Mississippi 39209

WATER WELL DRILLERS LOG

COUNTY WELL LOCATED: Wilkinson	
WELL NUMBER: E	CODED:
2008	
DATE WELL COMPLETED: 10-14-88	

PERMIT NUMBER	
NAME OF DRILLING FIRM	

NAME & MAILING ADDRESS OF LANDOWNER
Fermon Ulmer
Lake Mary Planting Co.
Woodville, Ms.

WELL LOCATION: SEC 24 TOWNSHIP 3 (N) S RANGE 4 E (W)

DISTANCE 18 Miles DIRECTION NW of NEAREST TOWN Woodville

OTHER LANDMARK: Lake Mary

WELL PURPOSE: Home, Irrigation, Municipal, Industrial, Fish Pond, etc.
Duck Pond

PUMP DATA

PUMP TYPE (Circle One):
Submersible, Turbine, Jet, Flowing Well,
Other (Describe) did not install

POWER TYPE (Circle One):
Electric, Tractor, Diesel, Gasoline, Butane,
Other (Describe) _____ H/P _____

Pump Capacity (GPM)	No. of Stages	Setting Depth
		FT.

PUMP TEST

Well yielded 14 GPM with a drawdown of 0 ft. after 2 hours of pumping

WELL DATA

Well Depth	Casing Diameter (In.)	Casing Length (Ft.)
115	4	95

Type of Casing	Hole Depth	Depth to Static Water Level
PVC	125	25

TYPE OF COMPLETION: (Circle One or More):
Gravel Packed, Underreamed, Telescoped, Natural Development, Open Hole, Other (Describe) _____

Top of Lap Pipe or Reduction in Casing
FEET

IF TELESCOPED OR MORE THAN ONE SCREEN: USE BACK PAGE

SCREEN DATA

Diameter - Inches	Length - Feet	Slot Size - Inches
4	20	.010

Screen Type	Depth to Bottom - Feet
PVC	115

LOG DATA

TYPE OF LOG RUN (Circle One): No Log Run, Electric, Gamma Ray, Density, Sonic, Neutron, Other (Describe) _____

Name of Organization Running Log

GEOLOGIC DATA (Office Use Only)

Surface Elev.	Geologic Unit	Unit Thickness	Depth to Top
Subs. SWL	Date	Analysis	Aquifer Test

Driller's Remarks

DESCRIPTION OF FORMATIONS ENCOUNTERED	FROM	TO
Clay	0	10
Sand	10	125

FORMATIONS (Continued) | FROM | TO

IF MORE SPACE IS NEEDED, USE BACK

RECEIVED
FEB 9 1989
Department of Natural Resources
Bureau of Land & Water Resources

If well telescopes please
sketch and show depths.

GROUND LEVEL

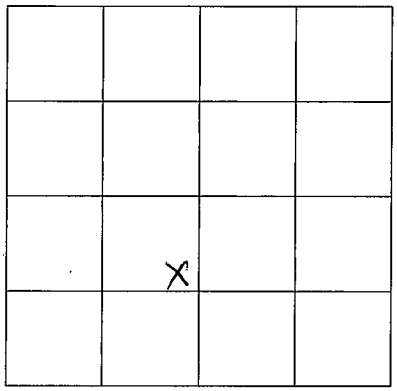

SECTION 24

Please indicate well location X.

ADDITIONAL INFORMATION

If more than one screen,
show location of each on sketch.