MISSISSIPPI DEPARTMENT OF ENVIRONMENTAL QUALITY
Office of Land and Water Resources

P. O. Box 10631
Jackson, MS 39289-0631
WATER WELL DRILLERS LOG

COUNTY WELL LOCATED	Wilkerson
WELL NUMBER	F-2013
CODED	
DATE WELL COMPLETED	7-6-00
PERMIT NUMBER	0-60
NAME OF DRILLING FIRM	Rayborn Drilling

NAME & MAILING ADDRESS OF LANDOWNER
Ben Mc Donald
8780 Henderson Rd.
Denham Springs, LA 70726

WELL LOCATION: SEC 12 TOWNSHIP 3 (N) S RANGE 3 E (W)

DISTANCE 5 Miles DIRECTION SW of NEAREST TOWN Doloroso

OTHER LANDMARK

WELL PURPOSE: (Home), Irrigation, Municipal, Industrial, (Fish Pond), etc.

PUMP DATA

PUMP TYPE (Circle One): (Submersible), Turbine, Jet, Flowing Well, Other (Describe) ____

POWER TYPE (Circle One): (Electric), Tractor, Diesel, Gasoline, Butane, Other (Describe) ____ H/P 5

Pump Capacity (GPM)	No. of Stages	Setting Depth
50		210 FT.

PUMP TEST

Well yielded ____ GPM with a drawdown of ____ ft. after ____ hours of pumping

WELL DATA

Well Depth	Casing Diameter (In.)	Casing Length (Ft.)
342	4	312
Type of Casing	**Hole Depth**	**Depth to Static Water Level**
PVC	342	90

TYPE OF COMPLETION: (Circle One or More): Gravel Packed, Underreamed, Telescoped, (Natural Development), Open Hole, Other (Describe) ____

WELL GROUTED TO A DEPTH OF 10 FEET
Type Grout (circle one): Cement, Bentonite, or Mix

LOG DATA

TYPE OF LOG RUN (Circle One): No Log Run, Electric, Gamma Ray, Density, Sonic, Neutron, Other (Describe) ____

Name of Organization Running Log

GEOLOGIC DATA (Office Use Only)

Surface Elev.	Geologic Unit	Unit Thickness	Depth to Top
Subs. SWL	Date	Analysis	Aquifer Test

Driller's Remarks

Top of Lap Pipe or Reduction in Casing

IF TELESCOPED OR MORE THAN ONE SCREEN: USE BACK PAGE

SCREEN DATA

Diameter - Inches	Length - Feet	Slot Size - Inches
4	30	.010
Screen Type	**Depth to Bottom - Feet**	
PVC	342	

RECEIVED
JUL 17 2000
Dept. of Environmental Quality
Office of Land & Water Resources

DESCRIPTION OF FORMATIONS ENCOUNTERED	FROM	TO	FORMATIONS (Continued)	FROM	TO
Topsoil	0	2			
Chalk	2	90			
Sand	90	100			
Chalk	100	140			
Fine Sand	140	220			
Shale	220	295			
Sand	295	342			
			IF MORE SPACE IS NEEDED, USE BACK		

If well telescopes please
sketch and show depths.

GROUND LEVEL

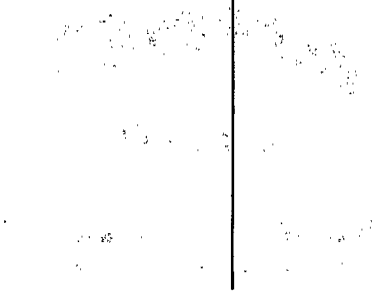

If more than one screen,
show location of each on sketch.

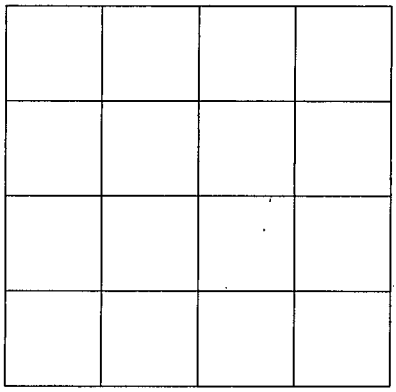

SECTION _____

Please indicate well location X.

ADDITIONAL INFORMATION