

WILK.

G3

10-15-60 CODED

WATER WELL DRILLERS LOG

~~6-302~~

Date: 10-15, 1960, Driller: Jerrine Serviso County: Jefferson  
(Name)

Ed. R. Wilson

- (1) Owner of Land: E. I. Davis  
Rt. 1, Box 217 (Name)  
Woodville, Miss.  
(Address)
- (2) Location: 1/4, 1/4, Sec. 15 T. 3 R. 20  
8 miles North of Woodville  
(distance) (direction) (Nearest Town)
- (3) Topography:  (Hilly)  (Flat)  (Level)
- (4) Purpose of Well: Domestic  
(Domestic Irrigation  
Municipal, Industrial, Other)

Description & Color of Materials Sand, Clay, Red Clay, Shell, etc.	Thick- ness Feet	Depth Feet
<u>Red Clay</u>	<u>25'</u>	<u>25'</u>
<u>Clay</u>	<u>20'</u>	<u>45'</u>
<u>Sand &amp; Gravel</u>	<u>7'</u>	<u>52'</u>
<u>Clay</u>	<u>100'</u>	<u>152'</u>
<u>Sand</u>	<u>8'</u>	<u>160'</u>
<u>Clay</u>	<u>30'</u>	<u>190'</u>
<u>Sand</u>	<u>16'</u>	<u>206'</u>


Information upon completion of well:

- (1) Diameter 4 3/4" inches.
- (2) Total Depth 206' feet.
- (3) Water Level 160' feet below top of ground.
- (4) Cased to 201', Size 2"
- (5) Screen: Size 2", Length 5'
- (6) Were any formations sealed against pollution?  
no

CODED

If YES depth of formation \_\_\_\_\_  
Why \_\_\_\_\_

Drillers Remarks: \_\_\_\_\_  
\_\_\_\_\_  
\_\_\_\_\_

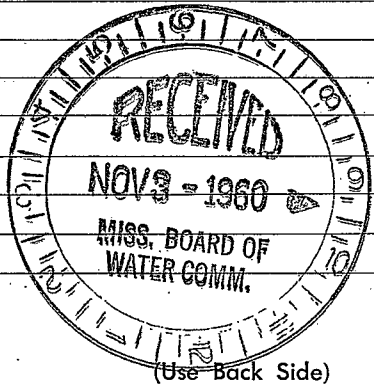

Well No.




