MISSISSIPPI DEPARTMENT OF NATURAL RESOURCES

Bureau of Land and Water Resources

P.O. Box 10631
Jackson, Mississippi 39209
WATER WELL DRILLERS LOG

COUNTY WELL LOCATED: Wilkinson	
WELL NUMBER: G	CODED:
2012	
DATE WELL COMPLETED: 11-22-88	

PERMIT NUMBER:

NAME OF DRILLING FIRM: KAYBURN DRILLING, INC.

Rt 5 Box 98
Natchez Ms 39120

NAME & MAILING ADDRESS OF LANDOWNER

Bunker Hill Hunting Club
c/o Mr. Don Browning
Commercial Bank

Woodville MS 39669

WELL LOCATION: SEC 27 TOWNSHIP 3 N/S RANGE 1 E/W

DISTANCE 7 Miles DIRECTION S of NEAREST TOWN Solarsso

OTHER LANDMARK

WELL PURPOSE: Home, Irrigation, Municipal, Industrial, Fish Pond, etc.

Home

PUMP DATA

PUMP TYPE (Circle One): Submersible, Turbine, Jet, Flowing Well, Other (Describe)

POWER TYPE (Circle One): Electric, Tractor, Diesel, Gasoline, Butane, Other (Describe)

Pump Capacity (GPM)	No. of Stages	Setting Depth
10	8	36 FT.

PUMP TEST 1/2

Well yielded 10 GPM with a drawdown of _____ ft. after _____ hours of pumping

WELL DATA

Well Depth	Casing Diameter (In.)	Casing Length (Ft.)
38'	4"	28'

Type of Casing	Hole Depth	Depth to Static Water Level
Sch 40 PVC	38'	20'

TYPE OF COMPLETION: (Circle One or More): Gravel Packed, Underreamed, Telescoped, Natural Development, Open Hole, Other (Describe)

Top of Lap Pipe or Reduction in Casing FEET

IF TELESCOPED OR MORE THAN ONE SCREEN: USE BACK PAGE

LOG DATA

TYPE OF LOG RUN (Circle One): No Log Run, Electric, Gamma Ray, Density, Sonic, Neutron, Other (Describe)

Name of Organization Running Log

GEOLOGIC DATA (Office Use Only)

Surface Elev.	Geologic Unit	Unit Thickness	Depth to Top
Subs. SWL	Date	Analysis	Aquifer Test

Driller's Remarks

SCREEN DATA

Diameter - Inches	Length - Feet	Slot Size - Inches
4"	10'	.010

Screen Type	Depth to Bottom - Feet
Sch 40 Slotted PVC	38'

RECEIVED
JAN 03 1989
Department of Natural Resources
Bureau of Land & Water Resources

DESCRIPTION OF FORMATIONS ENCOUNTERED	FROM	TO
Top Soil	0	28
Sand	28	38

FORMATIONS (Continued)	FROM	TO

IF MORE SPACE IS NEEDED, USE BACK

If well telescopes please
sketch and show depths.

GROUND LEVEL

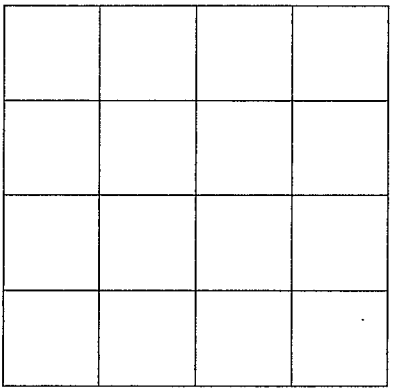

SECTION _____

Please indicate well location X.

ADDITIONAL INFORMATION

If more than one screen,
show location of each on sketch.