MISSISSIPPI DEPARTMENT OF ENVIRONMENTAL QUALITY
Office of Land and Water Resources

P. O. Box 10631
Jackson, MS 39289-0631
WATER WELL DRILLERS LOG

COUNTY WELL LOCATED	Wilkinson
WELL NUMBER	B2024
CODED	
DATE WELL COMPLETED	8-27-99
PERMIT NUMBER	O-621
NAME OF DRILLING FIRM	Daniel Boone
	Tylertown, MS

NAME & MAILING ADDRESS OF LANDOWNER
Peggy Turras
8346 Lower Woodville Rd
Woodville, MS.

WELL LOCATION	SEC	TOWNSHIP	RANGE
	32	3 (N) S	2 E (W)

DISTANCE	DIRECTION	NEAREST TOWN
8 1/2 Miles	NW	of Woodville

OTHER LANDMARK

WELL PURPOSE: Home, Irrigation, Municipal, Industrial, Fish Pond, etc.

PUMP DATA

PUMP TYPE (Circle One): Submersible, Turbine, Jet, Flowing Well, Other (Describe)

POWER TYPE (Circle One): Electric, Tractor, Diesel, Gasoline, Butane, Other (Describe) H/P 1

Pump Capacity (GPM)	No. of Stages	Setting Depth
12		140 FT.

PUMP TEST
Well yielded 18 GPM with a drawdown of 20 ft. after 18 hours of pumping

WELL DATA

Well Depth	Casing Diameter (In.)	Casing Length (Ft.)
270'	4"	250'

Type of Casing	Hole Depth	Depth to Static Water Level
PVC	272	112'

TYPE OF COMPLETION: (Circle One or More): Gravel Packed, Underreamed, Telescoped, Natural Development, Open Hole, Other (Describe)

WELL GROUTED TO A DEPTH OF 9 FEET
Type Grout (circle one): Cement, Bentonite, or Mix

SCREEN DATA

Diameter - Inches	Length - Feet	Slot Size - Inches
4"	20'	.008

Screen Type	Depth to Bottom - Feet
PVC Sch. 40	2'

LOG DATA

TYPE OF LOG RUN (Circle One): No Log Run, Electric, Gamma Ray, Density, Sonic, Neutron, Other (Describe)

Name of Organization Running Log

GEOLOGIC DATA (Office Use Only)

Surface Elev.	Geologic Unit	Unit Thickness	Depth to Top
Subs. SWL	Date	Analysis	Aquifer Test

Driller's Remarks

Top of Lap Pipe or Reduction in Casing
FEET — IF TELESCOPED OR MORE THAN ONE SCREEN: USE BACK PAGE

DESCRIPTION OF FORMATIONS ENCOUNTERED	FROM	TO	FORMATIONS (Continued)	FROM	TO
Red Clay	0	40			
Sand	40	90			
Blue Clay	90	240			
Sand	240	272			
			IF MORE SPACE IS NEEDED, USE BACK		

If well telescopes please
sketch and show depths.

GROUND LEVEL

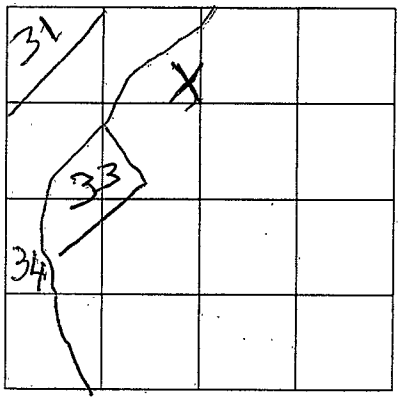

SECTION 32

Please indicate well location X.

ADDITIONAL INFORMATION

If more than one screen,
show location of each on sketch.