MISSISSIPPI DEPARTMENT OF NATURAL RESOURCES

Bureau of Land and Water Resources

P.O. Box 10631
Jackson, Mississippi 39209

WATER WELL DRILLERS LOG

COUNTY WELL LOCATED	Wilkinson
WELL NUMBER	4
CODED	
	2005
DATE WELL COMPLETED	7-21-89
PERMIT NUMBER	
NAME OF DRILLING FIRM	RAYBORN DRILLING, INC.

NAME & MAILING ADDRESS OF LANDOWNER

Fred Netterville Lumber Co.
Rt. 1 Box 855
Woodville Ms 39669

WELL LOCATION: SEC 23 TOWNSHIP T3 (N) S RANGE R1 (W) E

DISTANCE 15 Miles DIRECTION East of NEAREST TOWN Crosby

OTHER LANDMARK

WELL PURPOSE: Home, Irrigation, Municipal, Industrial, Fish Pond, etc.
Private

PUMP DATA

PUMP TYPE (Circle One): (Submersible,) Turbine, Jet Flowing Well, Other (Describe)

POWER TYPE (Circle One): (Electric,) Tractor, Diesel, Gasoline, Butane, Other (Describe)

Pump Capacity (GPM)	No. of Stages	Setting Depth
10	15	90 FT.

PUMP TEST

Well yielded 10 GPM with a drawdown of — ft. after — hours of pumping

WELL DATA

Well Depth	Casing Diameter (In.)	Casing Length (Ft.)
105'	4"	95'
Type of Casing	**Hole Depth**	**Depth to Static Water Level**
Sch 40 PVC	105'	50'

TYPE OF COMPLETION: (Circle One or More): ~~Gravel Packed,~~ Underreamed, Telescoped, (Natural Development,) Open Hole, Other ~~(Describe)~~

Top of Lap Pipe or Reduction in Casing FEET

IF TELESCOPED OR MORE THAN ONE SCREEN: USE BACK PAGE

SCREEN DATA

Diameter - Inches	Length - Feet	Slot Size - Inches
4"	10'	.010
Screen Type		**Depth to Bottom - Feet**
Sch 40 Slotted PVC		105'

LOG DATA

TYPE OF LOG RUN (Circle One): (No Log Run,) Electric, Gamma Ray, Density, Sonic, Neutron, Other (Describe)

Name of Organization Running Log

GEOLOGIC DATA (Office Use Only)

Surface Elev.	Geologic Unit	Unit Thickness	Depth to Top
Subs. SWL	Date	Analysis	Aquifer Test

Driller's Remarks

DESCRIPTION OF FORMATIONS ENCOUNTERED	FROM	TO	FORMATIONS (Continued)	FROM	TO
Top Soil	0	2			
Clay	2	95			
Sand	95	105			

IF MORE SPACE IS NEEDED, USE BACK

RECEIVED
AUG 06 1990
Department of Natural Resources
Bureau of Land & Water Resources

If well telescopes please
sketch and show depths.

GROUND LEVEL

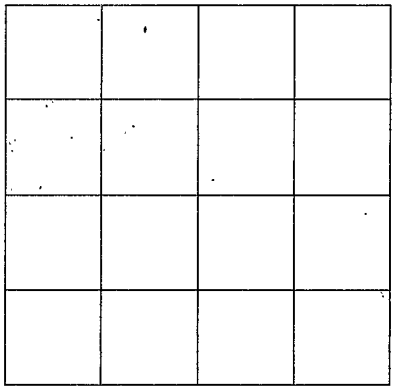

SECTION _____

Please indicate well location X.

ADDITIONAL INFORMATION

If more than one screen,
show location of each on sketch.