Wilkinson
93
7-68

CODED

MISSISSIPPI
BOARD OF WATER COMMISSIONERS
416 North State Street
Jackson, Mississippi 39201

WATER WELL DRILLERS LOG

July 27 1968 Reves well & Pump Co Wilkinson
date well completed firm name county well located

LANDOWNER: Joe Mathis
RFD 1
Crosby
(mailing address)

WELL LOCATION:
sec. 11 T 3 N R 1 E
9 miles SW of Crosby
(distance) (direction) (nearest town)

WELL PURPOSE: Home
(home, irrigation, municipal, industrial)

WELL COMPLETION DATA:
(1) diameter (inches) 2"
(2) total depth (feet) 146'
(3) static water level (feet) 9.5 below above top of ground.
(4) casing galv steel, Bottom,
(material) (depth)
(size) if telescope see back.
(5) screen 3½, 142½
(length) (depth to top)
1¼, Stainless steel
(size) (material)
(6) pump old hand pump
(HP) (yield gpm)
(type power)
(7) electric log No
(yes or no)
(organization running log)
(8) how well bottom plugged screen

DRILLERS REMARKS: old well dug

description of formations encountered	from	to
clay	0	12
white chalk	12	50
fine sand	50	62
blue chalk	62	84
fine sand	84	90
blue chalk	90	122
fine sand	122	130
coarse sand and big gravel	130	146

SEP 16 1968
MISS. BOARD OF WATER COMM.

If well telescopes please sketch and show depths.

GROUND LEVEL

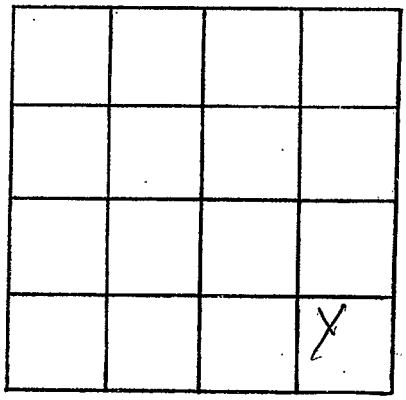

SECTION 11

Please indicate well location X.

ADDITIONAL INFORMATION

If more than one screen, show locations of each on sketch.