Wilkinson
L21

MISSISSIPPI DEPARTMENT OF NATURAL RESOURCES

Bureau of Land and Water Resource
Southport Mall
P.O. Box 10631
Jackson, Mississippi 39209

CODED

WATER WELL DRILLERS LOG

3-27 19 87 — date well completed
RAYBORN DRILLING, INC. — firm name
Wilkinson — county well located

LANDOWNER: Seeland Drlg.
900 Dunn St.
Houma LA 70360
(mailing address)

WELL LOCATION:
sec 50 T 2 (N) S R 3 E (W)
6 (distance) miles NE (direction) of Pond (nearest town)

WELL PURPOSE: airfield
(home, irrigation, municipal, industrial)

WELL COMPLETION DATA:

(1) diameter (inches) 4"
(2) total depth (feet) 250'
(3) static water level (feet) 200' (below) above top of ground.
(4) casing Sch40 PVC (material), 230' (depth), 4" (size) if telescope see back.
(5) screen 20' (length), 230' (depth to top), 4" (size), Slotted Sch40 PVC (material)
(6) pump 5 (HP) 60 (yield gpm)
electric (type power)
(7) electric log no (yes or no)
— (organization running log)
(8) how well bottom plugged wood

DRILLERS REMARKS:

description of formations encountered	from	to
Well Name: R.L. Prater #1		

RECEIVED
JUN 24 1987
Department of Natural Resources
Bureau of Land & Water Resources

If well telescopes please sketch and show depths.

GROUND LEVEL

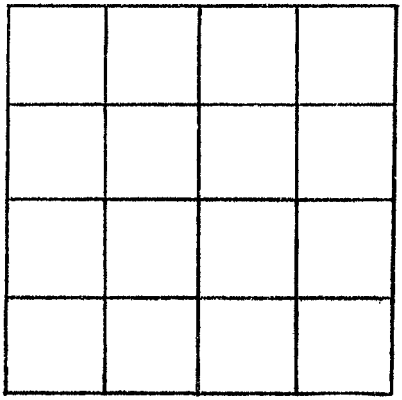

SECTION _____

Please indicate well location X.

ADDITIONAL INFORMATION

If more than one screen, show locations of each on sketch.