MISSISSIPPI DEPARTMENT OF ENVIRONMENTAL QUALITY
Office of Land and Water Resources

P. O. Box 10631
Jackson, MS 39289-0631
WATER WELL DRILLERS LOG

COUNTY WELL LOCATED: Wilkinson	PERMIT NUMBER: 0-60
WELL NUMBER: M 2017 CODED	NAME OF DRILLING FIRM: Rayburn Drilling
DATE WELL COMPLETED: 5-2-96	Natchez, MS

NAME & MAILING ADDRESS OF LANDOWNER
Charles Robinson
14615 Carey RD.
Baker, La. 70714

WELL LOCATION: SEC 8 TOWNSHIP 2 (N/S) RANGE 2 (E/W)

DISTANCE 4 Miles DIRECTION North NEAREST TOWN of Wesville

OTHER LANDMARK

WELL PURPOSE: Home, Irrigation, Municipal, Industrial, Fish Pond, etc.
home

PUMP DATA

PUMP TYPE (Circle One): Submersible, Turbine, Jet, Flowing Well, Other (Describe) _____

POWER TYPE (Circle One): Electric, Tractor, Diesel, Gasoline, Butane, Other (Describe) / H/P _____

Pump Capacity (GPM)	No. of Stages	Setting Depth
		FT.

PUMP TEST

Well yielded _____ GPM with a drawdown of _____ ft. after _____ hours of pumping

WELL DATA

Well Depth	Casing Diameter (In.)	Casing Length (Ft.)
397'	4"	377
Type of Casing	**Hole Depth**	**Depth to Static Water Level**
PVC	397'	250'

TYPE OF COMPLETION: (Circle One or More): Gravel Packed, Underreamed, Telescoped, Natural Development, Open Hole, Other (Describe) _____

WELL GROUTED TO A DEPTH OF _____ FEET
Type Grout (circle one): Cement, Bentonite, or Mix

LOG DATA

TYPE OF LOG RUN (Circle One): No Log Run, Electric, Gamma Ray, Density, Sonic, Neutron, Other (Describe) _____

Name of Organization Running Log

GEOLOGIC DATA (Office Use Only)

Surface Elev.	Geologic Unit	Unit Thickness	Depth to Top
Subs. SWL	Date	Analysis	Aquifer Test

Driller's Remarks

Top of Lap Pipe or Reduction in Casing
FEET (IF TELESCOPED OR MORE THAN ONE SCREEN, USE BACK PAGE)

SCREEN DATA

Diameter - Inches	Length - Feet	Slot Size - Inches
4"	20	.020
Screen Type		**Depth to Bottom - Feet**
Sch 40 PVC		397'

RECEIVED
JUN 05 1996
Dept. of Environmental Quality
Office of Land & Water Resources

DESCRIPTION OF FORMATIONS ENCOUNTERED	FROM	TO	FORMATIONS (Continued)	FROM	TO
TOP SOIL	0	4			
hard shell	4	300			
Sand	300	397			
			IF MORE SPACE IS NEEDED, USE BACK		

If well telescopes please
sketch and show depths.

GROUND LEVEL

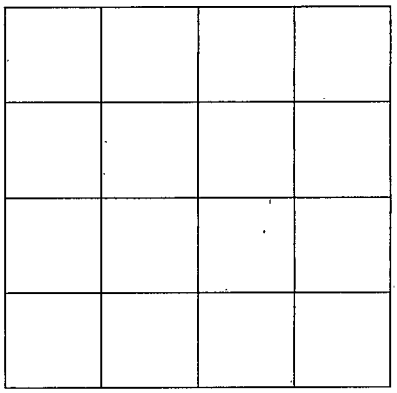

SECTION _____

Please indicate well location X.

ADDITIONAL INFORMATION

If more than one screen,
show location of each on sketch.