MISSISSIPPI DEPARTMENT OF ENVIRONMENTAL QUALITY
Office of Land and Water Resources

P. O. Box 10631
Jackson, MS 39289-0631
WATER WELL DRILLERS LOG

COUNTY WELL LOCATED: Wilkinson	
WELL NUMBER: Whitebank-Hunter #1	CODED
DATE WELL COMPLETED: 9-27-95	PERMIT NUMBER: O-60
	NAME OF DRILLING FIRM: Rayburn Drilling, Natchez, MS

NAME & MAILING ADDRESS OF LANDOWNER
D & D Drilling
P O Box 351
Jerniday, La

WELL LOCATION: SEC 2 & 5 TOWNSHIP 1 (N) S RANGE 3 (E) W

DISTANCE 3 Miles DIRECTION East of NEAREST TOWN Woodville

OTHER LANDMARK

WELL PURPOSE: Home, Irrigation, Municipal, Industrial, Fish Pond, etc.
Oilfield

PUMP DATA

PUMP TYPE (Circle One): Submersible, Turbine, Jet, Flowing Well, Other (Describe) Air

POWER TYPE (Circle One): Electric, Tractor, Diesel, Gasoline, Butane, Other (Describe) _____ H/P _____

Pump Capacity (GPM)	No. of Stages	Setting Depth
		FT.

PUMP TEST

Well yielded _____ GPM with a drawdown of _____ ft. after _____ hours of pumping

WELL DATA

Well Depth	Casing Diameter (In.)	Casing Length (Ft.)
117'	3"	87'

Type of Casing	Hole Depth	Depth to Static Water Level
PVC	117'	30'

TYPE OF COMPLETION: (Circle One or More): Gravel Packed, Underreamed, Telescoped, Natural Development, Open Hole, Other (Describe) _____

WELL GROUTED TO A DEPTH OF _____ FEET
Type Grout (circle one): Cement, Bentonite, or Mix

LOG DATA

TYPE OF LOG RUN (Circle One): No Log Run, Electric, Gamma Ray, Density, Sonic, Neutron, Other (Describe) _____

Name of Organization Running Log

GEOLOGIC DATA (Office Use Only)

Surface Elev.	Geologic Unit	Unit Thickness	Depth to Top
Subs. SWL	Date	Analysis	Aquifer Test

Driller's Remarks

SCREEN DATA

Diameter - Inches	Length - Feet	Slot Size - Inches
3"	30	.020

Screen Type	Depth to Bottom - Feet
SCH 40 PVC	117

Top of Lap Pipe or Reduction in Casing

IF TELESCOPED OR MORE THAN ONE SCREEN, USE BACK PAGE

RECEIVED
DEC 18 1995
Dept. of Environmental Quality
Office of Land & Water Resources

DESCRIPTION OF FORMATIONS ENCOUNTERED	FROM	TO
TOP Soil	0	2
Chalk	2	16
Sand	16	90
Chalk	90	92
Sand	92	117

FORMATIONS (Continued)	FROM	TO

IF MORE SPACE IS NEEDED, USE BACK

If well telescopes please
sketch and show depths.

GROUND LEVEL

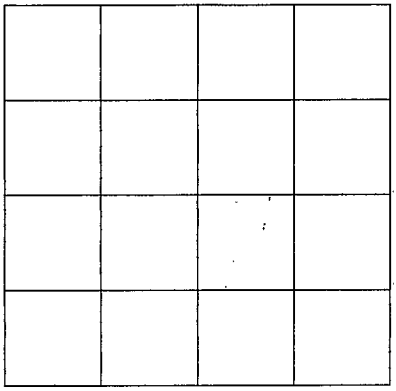

SECTION _____

Please indicate well location X.

ADDITIONAL INFORMATION

If more than one screen,
show location of each on sketch.