MISSISSIPPI DEPARTMENT OF ENVIRONMENTAL QUALITY
Office of Land and Water Resources

P. O. Box 10631
Jackson, MS 39289-0631
WATER WELL DRILLERS LOG

COUNTY WELL LOCATED: Wilkinson	
WELL NUMBER: Q-2014	CODED:
DATE WELL COMPLETED: 6-30-00	
PERMIT NUMBER: 0-621	
NAME OF DRILLING FIRM: Daniel Boone	

NAME & MAILING ADDRESS OF LANDOWNER
Douglass Bordelon
5610 Woodstock Rd.
Pickneyville, MS

WELL LOCATION: SEC 33 TOWNSHIP 1 (N/S) RANGE 3 (E/W)

DISTANCE 2 Miles DIRECTION E of NEAREST TOWN Pickneyville

OTHER LANDMARK

WELL PURPOSE: Home, Irrigation, Municipal, Industrial, Fish Pond, etc.

PUMP DATA

PUMP TYPE (Circle One): Submersible, Turbine, Jet, Flowing Well, Other (Describe)

POWER TYPE (Circle One): Electric, Tractor, Diesel, Gasoline, Butane, Other (Describe) H/P 1

Pump Capacity (GPM)	No. of Stages	Setting Depth
12		130 FT.

PUMP TEST
Well yielded 16 GPM with a drawdown of 15 ft. after 6 hours of pumping

WELL DATA

Well Depth	Casing Diameter (In.)	Casing Length (Ft.)
155'	4"	135'
Type of Casing	**Hole Depth**	**Depth to Static Water Level**
PVC	155'	105

TYPE OF COMPLETION: (Circle One or More): Gravel Packed, Underreamed, Telescoped, Natural Development, Open Hole, Other (Describe)

WELL GROUTED TO A DEPTH OF 10 FEET
Type Grout (circle one): Cement, Bentonite, or Mix

LOG DATA

TYPE OF LOG RUN (Circle One): No Log Run, Electric, Gamma Ray, Density, Sonic, Neutron, Other (Describe)

Name of Organization Running Log

GEOLOGIC DATA (Office Use Only)

Surface Elev.	Geologic Unit	Unit Thickness	Depth to Top
Subs. SWL	Date	Analysis	Aquifer Test

Driller's Remarks

SCREEN DATA

Diameter - Inches	Length - Feet	Slot Size - Inches
4"	20'	.008
Screen Type	**Depth to Bottom - Feet**	
PVC Sch. 40	0	

Top of Lap Pipe or Reduction in Casing
FEET IF TELESCOPED OR MORE THAN ONE SCREEN USE BACK PAGE

DESCRIPTION OF FORMATIONS ENCOUNTERED	FROM	TO	FORMATIONS (Continued)	FROM	TO
Clay	0	23			
Sand	23	110			
Clay	110	114			
Sand	114	155			
			IF MORE SPACE IS NEEDED, USE BACK		

RECEIVED
AUG 07 2000
Dept. of Environmental Quality
Office of Land & Water Resources

If well telescopes please
sketch and show depths.

GROUND LEVEL

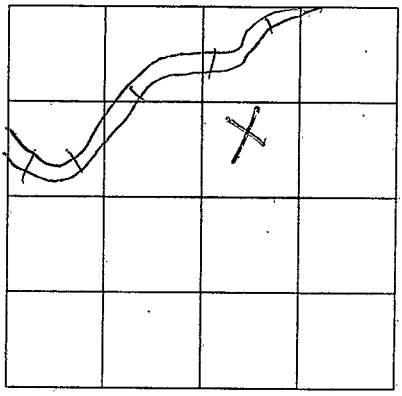

SECTION 33

Please indicate well location X.

ADDITIONAL INFORMATION

If more than one screen,
show location of each on sketch.