MISSISSIPPI DEPARTMENT OF ENVIRONMENTAL QUALITY
Bureau of Land and Water Resources

P. O. Box 10631
Jackson, MS 39289-0631
WATER WELL DRILLERS LOG

COUNTY WELL LOCATED	Wilkinson
WELL NUMBER	R
CODED	
	2013
DATE WELL COMPLETED	6-12-93
PERMIT NUMBER	0-60
NAME OF DRILLING FIRM	Raylorn Drilling, Inc. Natchez, Ms 39120

NAME & MAILING ADDRESS OF LANDOWNER
Audrey Lee Veals
1173 Cherryfield Rd.
Woodville, Ms 39669

WELL LOCATION: SEC 35 TOWNSHIP 1 N/S RANGE 2 E/W

DISTANCE 7 Miles DIRECTION South of NEAREST TOWN Woodville

OTHER LANDMARK

WELL PURPOSE: Home, Irrigation, Municipal, Industrial, Fish Pond, etc.
Home

PUMP DATA

PUMP TYPE (Circle One): Submersible, Turbine, Jet Flowing Well, Other (Describe)

POWER TYPE (Circle One): Electric, Tractor, Diesel, Gasoline, Butane, Other (Describe) 3/4 H/P

Pump Capacity (GPM)	No. of Stages	Setting Depth
12	10	128 FT.

PUMP TEST

Well yielded _____ GPM with a drawdown of _____ ft. after _____ hours of pumping

WELL DATA

Well Depth	Casing Diameter (In.)	Casing Length (Ft.)
130'	4"	120'
Type of Casing	**Hole Depth**	**Depth to Static Water Level**
PVC	130'	20'

TYPE OF COMPLETION: (Circle One or More): Gravel Packed, Underreamed, Telescoped, Natural Development, Open Hole, Other (Describe)

Top of Lap Pipe or Reduction in Casing FEET

IF TELESCOPED OR MORE THAN ONE SCREEN: USE BACK PAGE

LOG DATA

TYPE OF LOG RUN (Circle One): No Log Run, Electric, Gamma Ray, Density, Sonic, Neutron, Other (Describe)

Name of Organization Running Log

GEOLOGIC DATA (Office Use Only)

Surface Elev.	Geologic Unit	Unit Thickness	Depth to Top
Subs. SWL	Date	Analysis	Aquifer Test

Driller's Remarks

SCREEN DATA

Diameter - Inches	Length - Feet	Slot Size - Inches
4"	10'	.010
Screen Type		**Depth to Bottom - Feet**
SCH 40 PVC		130'

DESCRIPTION OF FORMATIONS ENCOUNTERED	FROM	TO
TOP SOIL	0	15
Sand	15	80
Chalk	80	120
Sand	120	130

FORMATIONS (Continued)	FROM	TO

RECEIVED
JUN 23 1993
Dept. of Environmental Quality
Office of Land & Water Resources

IF MORE SPACE IS NEEDED, USE BACK

If well telescopes please
sketch and show depths.

GROUND LEVEL

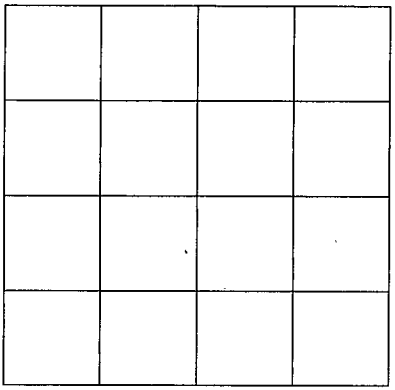

SECTION _____

Please indicate well location X.

ADDITIONAL INFORMATION

If more than one screen,
show location of each on sketch.