

WILKINSON

T5

11-66 MISSISSIPPI BOARD OF WATER COMMISSIONERS

CODED

CODED

WATER WELL DRILLERS LOG

Date: 11, 1966, Driller: Chester Reeves County Wilkinson
 (When well drilled) (Name) (Where well is located)

(1) Owner of Land:	Description & Color of Materials Sand, Clay, Red Clay, Shell, etc.	Thick- ness Feet	Depth Feet
<u>James Casan</u> (Name) <u>Centreville</u> (Address)	<u>Red Clay</u>	<u>20</u>	<u>0-20</u>
(2) Location: <u>1/4</u> , <u>1/4</u> , Sec. <u>4</u> T. <u>7N</u> R. <u>1E</u> <u>1</u> miles <u>south</u> of <u>Centreville</u> (distance) (direction) (Nearest Town)	<u>Red sand</u>	<u>40</u>	<u>20-60</u>
(3) Topography: <u>Hilly</u> (Hilly) (Flat) (Level)	<u>Hard brown</u>		
(4) Purpose of Well: <u>Domestic</u> (Domestic Irrigation Municipal, Industrial, Other)	<u>gravel</u>	<u>22</u>	<u>82</u>

Information upon completion of well:

(1) Diameter 4 inches.

(2) Total Depth 82 feet.

(3) Water Level 66 feet below top of ground.

(4) Cased to Ballant Size _____

(5) Screen: Size 4", Length 6'

(6) Were any formations sealed against pollution?
 yes, no.

CODED

If YES depth of formation _____


Why _____

Drillers Remarks: _____

Yield in gpm: _____

Size pump: _____

Type power: _____

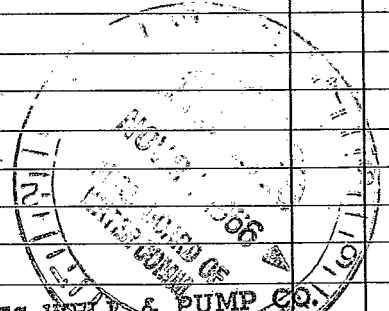

REEVES WELL & PUMP CO.
 P. O. BOX 71 PHONE 684-4351
 McCOMB, MISS.




