

WINSTON MISSISSIPPI BOARD OF WATER COMMISSIONERS

WEIS CODED
7-1-64

5 131
WATER WELL DRILLERS LOG

Date: 7-1, 1964, Driller: MERRITT Drilling County WINSTON
FELIX (Name)

(1) Owner of Land: Felix Wright
(Name)
Louisville, Miss
(Address)
32 15 12
(2) Location: 1/4, 1/4, Sec. T R
2 miles S.W. of Louisville
(distance) (direction) (Nearest Town)
(3) Topography: Hilly
(Hilly) (Flat) (Level)
(4) Purpose of Well: Domestic
(Domestic Irrigation
Municipal, Industrial, Other)


Description & Color of Materials Sand, Clay, Red Clay, Shell, etc.	Thick- ness Feet	Depth Feet
<u>Sea Field SAND.</u>	<u>0</u>	<u>12</u>
<u>WHITE CLAY.</u>	<u>12</u>	<u>21</u>
<u>GREY CLAY.</u>	<u>21</u>	<u>30</u>
<u>Soft White CLAY</u>	<u>30</u>	<u>50</u>
<u>White Sand.</u>	<u>50</u>	<u>54</u>
<u>LIQ NITE</u>	<u>54</u>	<u>57</u>
<u>Blue Gumbo</u>	<u>57</u>	<u>76</u>
<u>GREY CLAY.</u>	<u>76</u>	<u>98</u>
<u>Blue CLAY</u>	<u>78</u>	<u>94</u>
<u>LIQ NITE</u>	<u>94</u>	<u>96</u>
<u>Blue clay</u>	<u>96</u>	<u>110</u>
<u>Blue SAND</u>	<u>110</u>	<u>132</u>

Information upon completion of well:

(1) Diameter 2 inches.
(2) Total Depth 132 feet.
(3) Water Level 86 feet below top of ground.
(4) Cased to 105, Size 2"
(5) Screen: Size Open, Length _____
(6) Were any formations sealed against pollution?
Shale trap up
yes, no.
105 FT
If YES depth of formation _____

Why _____

Drillers Remarks: _____

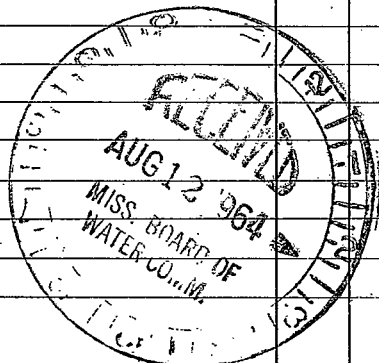

(Use Back Side)

Well No.







