

F 24

WATER WELL DRILLERS LOG

WINSTON

Date: 11-19, 1964, Driller: MERRITT DANNING, County CO.

(Name)

Owner of Land: Pearl Deceant, Algie Rogers (Name)

RT. 5, Louisville, Miss (Address)

Location: 2 1/4, 15-13, Sec. T R

7 miles EAST of Louisville (distance, direction, Nearest Town)

Topography: Hilly (Hilly, Flat, Level)

Purpose of Well: Domestic (Domestic Irrigation, Municipal, Industrial, Other)

Table with 3 columns: Description & Color of Materials, Thickness Feet, Depth Feet. Rows include: TOP SOIL, Red clay, Yellow clay sand, Blue Gumbo, Blue sand to clay, Rock, GRAY SAND in course.

Information upon completion of well:


- (1) Diameter 2 inches.
(2) Total Depth 168 feet.
(3) Water Level 50 feet below top of ground.
(4) Cased to 157, Size 2"
(5) Screen: Size 2", Length 6'
(6) Were formations sealed against pollution?

yes, no.

If YES depth of formation

Why

Drillers Remarks:

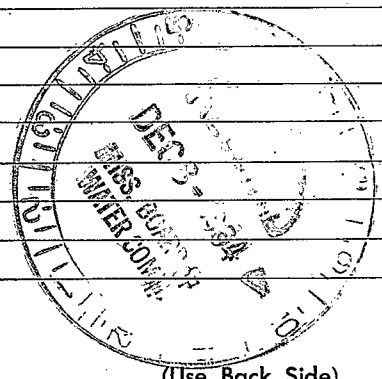

(Use Back Side)

Well No.







