

WINSTON
① J18
4-27-62

MISSISSIPPI BOARD OF WATER COMMISSIONERS
CODED 3 137

WATER WELL DRILLERS LOG

Date: 4/27/62 Driller: L. K. Merritt County Winston
(Name)

(1) Owner of Land: W. J. Carter
(Name)
Louisville Miss.
(Address) 2214-11

(2) Location: 1/4, 1/4, Sec. 22 T. R.
7 miles West of Louisville
(distance) (direction) (Nearest Town)

(3) Topography: (Hilly) (Flat) (Level)

(4) Purpose of Well: Domestic
(Domestic Irrigation, Municipal, Industrial, Other)

Description & Color of Materials Sand, Clay, Red Clay, Shell, etc.	Thick- ness Feet	Depth Feet
Hard Ferruginous Clay	0	10
Thin Sand Trace	10	37
Clay		
Med. Soft Blue Clay	37	58
Hard Lignite	58	64
Soft blue Clay	64	85
Soft Green Clay	85	89
Med. Hard Grey Clay	89	100
Trace of shale		
Soft grey clay, trace	100	124
of weathered sand + shale		
Med. Hard Clay	124	135
Shale, weathered sand		
Trace of clay in layers	135	209

Information upon completion of well:

(1) Diameter 2 inches.

(2) Total Depth 209 feet.

(3) Water Level 181 feet below top of ground.


(4) Cased to 126, Size 2

(5) Screen: Size Open, Length _____

(6) Were any formations sealed against pollution?
 yes, _____ no.

If YES depth of formation 2 shale
Why top of 126'

Drillers Remarks:

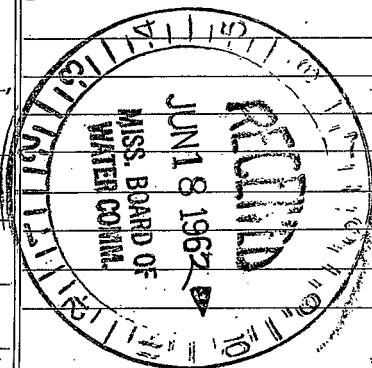

(Use Back Side)

Well No.










