

WINSTON

MISSISSIPPI BOARD OF WATER COMMISSIONERS.

K 16
6-4-64

CODED

6 137

WATER WELL DRILLERS LOG

Date: 6-4, 1964, Driller: MERRITT DRILLING CO. County WINSTON

(Name)

- (1) Owner of Land: BOBBY LOVERN
(Name)
LOUISVILLE, MISS.
(Address)
- (2) Location: 2 1/4 - 12
H miles SE. of LOUISVILLE
(distance) (direction) (Nearest Town)
- (3) Topography: HILLY
(Hilly) (Flat) (Level)
- (4) Purpose of Well: DOMESTIC
(Domestic Irrigation
Municipal, Industrial, Other)

Description & Color of Materials Sand, Clay, Red Clay, Shell, etc.	Thick- ness Feet	Depth Feet
Red CLAY	0	17
Blue CLAY	17	27
lignite	27	32
Blue CLAY	32	46
Rock	46	47
Blue clay	47	60
SAND VEAFINE	60	121
Blue SAND + SILT	121	147
VEAFINE Blue SAND	147	212
VEAFINE SAND + CLAY	212	244
Rock	244	245
Coarse white sand	245	253


Information upon completion of well:

- (1) Diameter 2 inches.
- (2) Total Depth 253 feet.
- (3) Water Level 84 feet below top of ground.
- (4) Cased to 245', Size 2"
- (5) Screen: Size 2", Length 5'
- (6) Were any formations sealed against pollution?
yes, no.

If YES depth of formation _____

Why _____

Drillers Remarks: _____

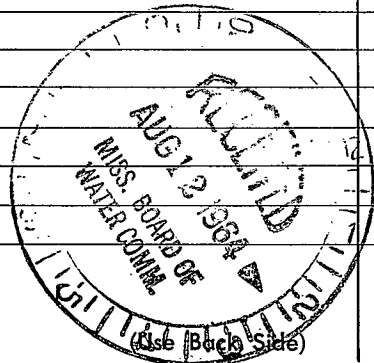

Well No. _____








