

WATER WELL DRILLERS LOG

L5

6 13 T

Date: 11-17, 19 64, Driller: MERRITT DANNING County WINSTON
 (Name)


(1) Owner of Land: <u>ELKIN HUDSPETH</u> <small>(Name)</small>	Description & Color of Materials Sand, Clay, Red Clay, Shell, etc.	Thick- ness Feet	Depth Feet
<u>RFD #1 LOUISVILLE MISS</u> <small>(Address)</small>	<u>TOP SOIL</u>	<u>02</u>	
<u>11 14-1/2</u> <small>(Address)</small>	<u>RED CLAY</u>	<u>215</u>	
<u>6</u> miles <u>EAST</u> of <u>LOUISVILLE</u> <small>(distance) (direction) (Nearest Town)</small>	<u>3 Blue bumps</u>	<u>1548</u>	
<u>Hilly</u> <small>(Hilly) (Flat) (Level)</small>	<u>FINE WHITESAND</u>	<u>48110</u>	
<u>DOMESTIC</u> <small>(Purpose of Well: Domestic Irrigation, Municipal, Industrial, Other)</small>	<u>COURSE SAND</u>	<u>110126</u>	

Information upon completion of well:

- (1) Diameter 2 inches.
- (2) Total Depth 126 feet.
- (3) Water Level 50 feet below top of ground.
- (4) Cased to 120, Size 2
- (5) Screen: Size 2, Length 4
- (6) Were any formations sealed against pollution?
 _____ yes, U no.

If YES depth of formation _____
 Why _____

Drillers Remarks: _____

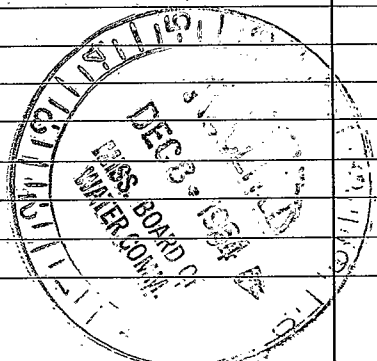

(Use Back Side)

Well No.












